


DX 78-1 Barton

**KANSAS**

Section 3 Township 17 Range 13W

Well No. #5 Putnam "B"

Company Skelly Oil

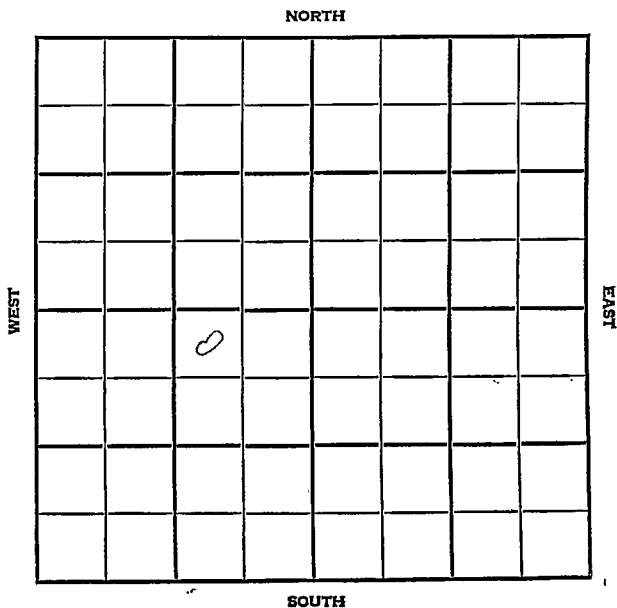

Barton

KANSAS

SEC. 3

TWP. 17

R. 13W

WELL NO.

#5 Putnam "B"

FARM

COMPANY

Skelly Oil

CONTRACTOR

Wentworth

S. Ainsworth


\_\_\_\_\_ FT. FROM N. LINE

\_\_\_\_\_ FT. FROM S. LINE

\_\_\_\_\_ FT. FROM E. LINE

\_\_\_\_\_ FT. FROM W. LINE

NE NW SW

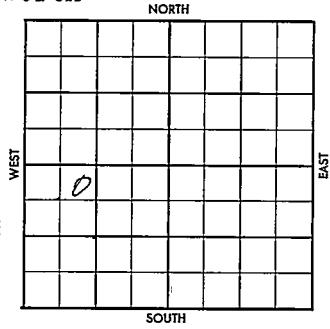

1956

ELEVATION

REPORT

8-22

Location



County Barton Elev. 1949  
 Sec. 3 Twp. 17 Rge. 13W  
 Company Skelly Oil  
 FarmName Putnam "BW" No. 5

TOPS	DEPTH	LOG	DATUM	Loc. in Sec.
Anh.	873			NE NW SW
Top.	2805			
H.	3084'			
Tr.	3102			
Dg.	3113			
Bl.	3166			
L.	3179			
K.C.				Geol.
B.K.C.				Contr.
Ce.				Wentworth
C.	3410			
M.				Pool
M.				S. Ainsworth
K.				
Mz.				<div style="border: 1px solid black; padding: 5px; text-align: center;"> <p><b>COMPLETE</b></p> <p>SEP 19 '56</p> </div>
Me.				
V.				
S.				
S.				
A.	3433			
R.				
PE.				
G.				
TD.	3435			

Date Comm. \_\_\_\_\_  
 Location AUG 29 '56 8-20-56  
PT 875/400 @ 2620  
DST 3179-3230 1hr rec 50 SEP 5 '56  
150CM @ W BHP 190 DST 3291  
-3336 1hr rec 30' @ Md BHP  
120 5 1/2 @ 3434 / 125 SEP 12 '56 ✓ SEP 19 '56  
DD 3438 TD tst 15 Gwph  
PB 3424 72/3412-20 400 acid  
tst 15 Gwph 4 hrs PB 3409

12/3403-07 +57 13 Gwph  
4 hrs PB 3240 27/3219-22  
32/3212-15 27/3205-08  
~~2 1/2~~ ♂ 9 BW in 14 hrs  
PB 3200 27/3195-98 99/  
3180-91 ~~1 1/2~~ ♂ 4 BW in 11  
hrs ~~2 1/2~~ ♂ 4 B0 + 6 BW  
in 3 hrs co 3238 P. 23  
B0 + 38 BW in 24 hrs)