
FORM 51 25M 3-49 PETROL KANSAS Russell

Section 18 Township 12 Range 15-W

Well No. #2 Holland

Company Stearn Pet.
Fairport Pool

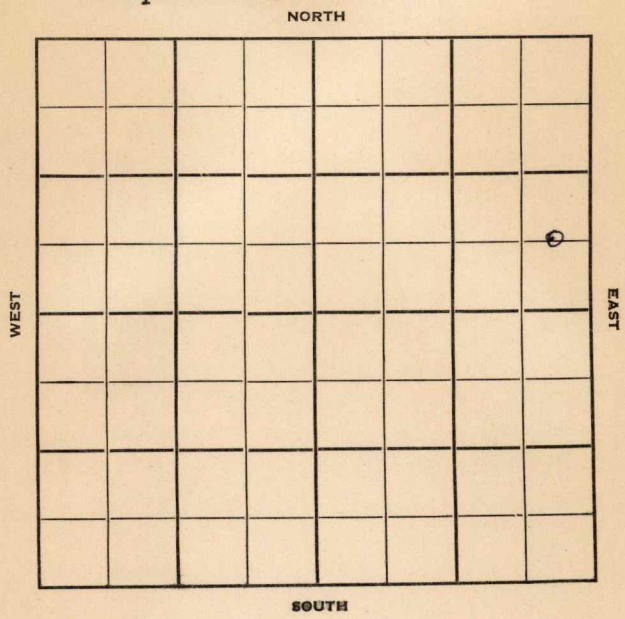

FORM 252-A
5M 10-48 PETROL

Russell KANSAS

Sec. 18 Twp. 12 R. 15W

Well No. #2 Holland Farm

Stearn Pet. Company

Fairport Pool (Stearns, Contr.)


_____ Ft. from N. Line

660' Ft. from S. Line

330' Ft. from E. Line

_____ Ft. from W. Line

C E L SE NE

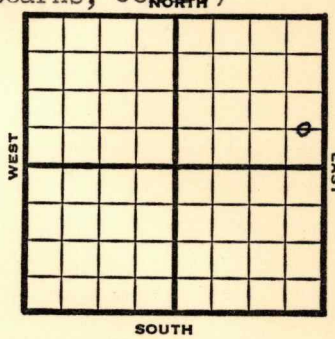

1949	Elev 1849' REPORT
11/30	RUR
12/7	8"@ 607' Drlg 1430'
12/14	Lansing 2950' Drlg. 3038'
12/21	Cong 3241 Granite Wash 3293' Granite 3303-12' TD 3312' 5"@ 3310'
12/28	48 shots 3254-64 CO
1950 1/11	TD 3312' 8"@ 607' 5"@ 3310' Perf 48/3254-64 PP 100 BOPD trace of wtr. Anh 892' Heeb 2903' Lan 2950' Cong 3241' Granite wash 3293' Granite 3303' Comp

COMPLETED

Form 26 200 Bks. 6-49 Petrol

Kansas

Fairport Pool

Map No. _____ Sec. 18 Twp. 12 R. 15W

Well No. 2 Holland


Stearn Pet. Company

Stearns Contractor

C E L SE NE

FIRST REPORT

SECTION PLAT

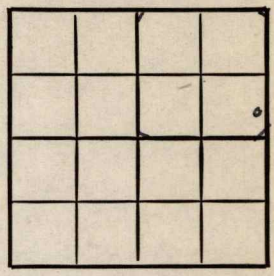

_____ Ft. from N. Line

660 Ft. from S. Line

330 Ft. from E. Line

_____ Ft. from W. Line

Russell County

Location _____

Rig up _____

Drilling and Remarks:

R U R

RECORD

Cased _____ in., _____ ft.

Sand _____

Gas _____

Oil _____

Total Depth _____

PRODUCTION

1st 24 hrs. Nat. _____

1st 24 hrs. after shot _____

Gas _____ Cu. Ft.

Dry Hole _____

Abandoned _____

Date

NOV 30 1949

19 S. J. LEWIS Scout

Form 26 200 Bks. 6-49 Petrol Abandoned Fairport Pool

Map No. Sec. 18 Twp. 12 R. 15W


Well No. 2 Holland

Stearns Pet. Company

Contractor

C E L SE NE Elv 1849

SECTION PLAT

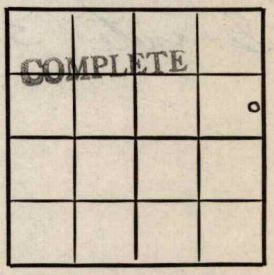

Ft. from N. Line

660 Ft. from S. Line

330 Ft. from E. Line

Ft. from W. Line

Russell County

Location

Rig up

Drilling and Remarks:

8" @ 607
5" @ 3310
Perf - 48/3254-64
PP 100 BOPD
trace of water

RECORD

Cased in., ft.

Sand

Gas

Oil

Total Depth 3312

PRODUCTION

1st 24 hrs. Nat.

1st 24 hrs. after shot

Gas Cu. Ft.

Dry Hole


Abandoned

Date

JAN 11 1950 19

J. E. TYRA Scout

ank 892
Keeb 2903
Lan 2950
Conq 3241
granitewash 3293
Granite 3303

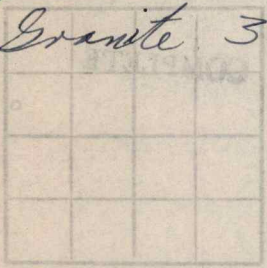

JAN 16 1950

Edith

Scout Cards
Land Small Map
Land Wall Map 5
Tracings
France Map
Pierce Map
Misc.