


Section 18 Township 12 Range 15W

Well No. #4 Holland

Company Stearns Drlg.

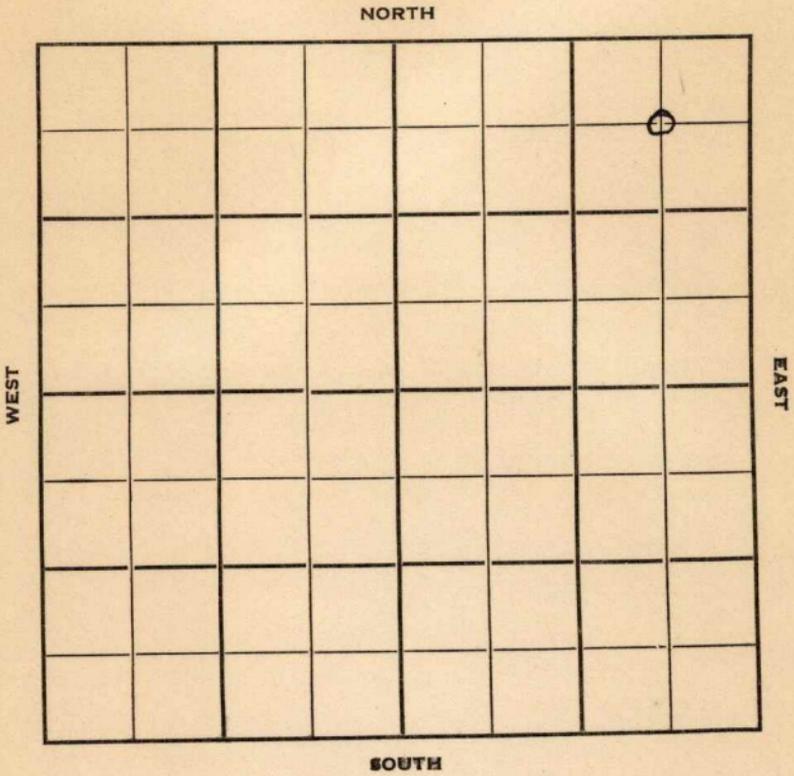

Sec. 18 Twp. 12 R. 15W ✓

Well No. #4 Holland Farm

Stearns Drlg. Company

Stearns Drlg. Contractor


Fairport Pool

660' Ft. from N. Line

_____ Ft. from S. Line

660' Ft. from E. Line

_____ Ft. from W. Line

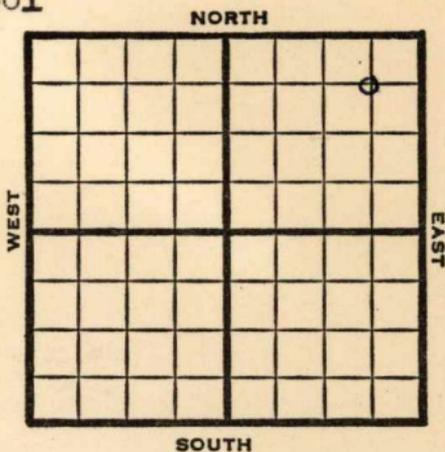

C NE NE

1950

Elev. 1816'

REPORT

9/27

Spud 9-19-50
8-5/8" @ 202'
Anhy 876'
Drlg. 1750'

11/1

Spud 9-19-50
oil Well TD 3290
8-5/8" 202 **Anhy 876'**
Lans. 2955' **Sand 3232'**
Cong. 3249-90 TB
5" @ 3290 CO to 3270
24/3243-48 FU 1350' oil
Comp. 60 HOPD

COMPLETED


County Russell State Kansas

Sec. 18 (Blk. Twp.) 12 (Sur. Rge.) 15W Map No.

Operator Stearns Drlg.

Well No. 4 Farm Holland

Elev. 1816 Location C NE NE

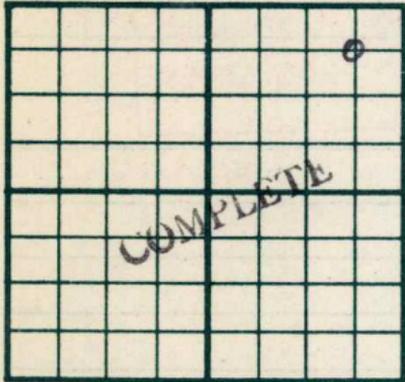

660 Ft. From N Line NE

660 Ft. From E Line Quarter

1st. Report

Completion NOV 1 1950

Remarks Fairport Pool

Stearns Drlg. - Contr.

Spudding Date 9-19-50

Drlg. Data Oil well TD 3290

8 5/8" @ 202 Anhy 876 Lans. 2955

Sand 3232 Cong. 3249-90 TD 5" @ 3290

CO to 3270 24/ 3243-48 FU 1350' oil

Comp. 60 bopd

J. E. TYRA