

Section 4 Township 17 Range 13 WWell No. # 8 DrakeCompany N.C.R.A.

NORTH

WEST

EAST

SOUTH

O

Barton KANSAS

Sec. 4 Twp. 17 R. 13 W

Well No. # 8 Drake Farm

N C R A

Company

Lindas

Contractor

Ainsworth


Ft. from N. Line

330 Ft. from S. Line

Ft. from E. Line

990 Ft. from W. Line

SE SW SE

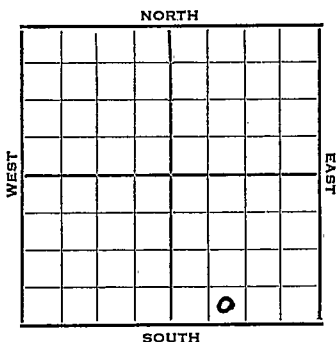

1952

Elev. 1900'

R E P O R T

4/9

Spud 4-4-52

8" @ 250'

Anhy 840'

Drlg. 1920'

4/23

Spud 2-4-52

D&A TD 3383 8" @ 250

Anhy 840'

Heeb. 3039

Br Lm 3122

Lans. 3135

DST 3138-88 open 2 hr.


Rec. 540' mud 360' SW

Arb. 3379

DST 3380-83, open 1 hr. rec. 15'

vsocm TD 3383 D&A

ABANDONED

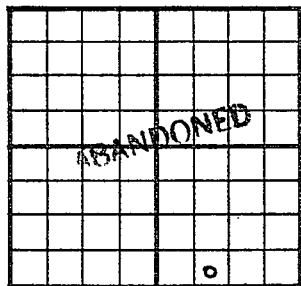County Barton State KansasSec. 4 (Blk. Twp.) 17 (Sur. Rge.) 13W Map No.Operator N C R AWell No. 8 Farm DrakeElev. 1900 Location SE SW SE330 Ft. From S Line SE990 Ft. From W Line Quarter

1st. Report

Completion APR. 23 1952Remarks Ainsworth PoolLindas - Contr.Spudding Date 4-4-52Drilg. Data D & A TD 33838" @ 250 Anhy 840 Heeb. 3039Br. lime 3122 Lans. 3135 DST 3138-88open 2 hr. Rec. 540' mud 360' swArb. 3379 DST 3380-83 open 1 hr.Rec. 15' vsocm TD 3383D & A

J. G. McGEHEE