

Section 3 Township 12 Range 16W

Well No. #1 Dreiling

Company Derby & Kiowa

Wildcat

NORTH

			Q				

WEST

EAST

SOUTH

Sec. 3 Twp. 12 R. 16W

Well No. #1 Dreiling Farm _____


Derby & Kiowa Company _____

330 Ft. from N. Line

_____ Ft. from S. Line

330 Ft. from E. Line

_____ Ft. from W. Line

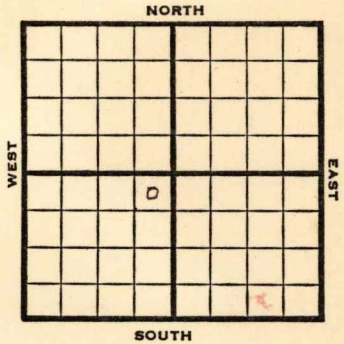

NE SW

1948

Elev. 1809' REPORT

- 4/7 Location
- 4/14 "
- 4/21 "
- 4/28 RUR
- 5/5 13" @ 140'
Drlg. 725'
- 5/12 8" @ 990'
Drlg. 2205'
- 5/19 Lansing 3019'
Drlg. 3260'
- 5/26 Arbuckle 3367'
TD 3385'

ABANDONED

Map No. _____ Sec. 3 Twp. 12 R. 16W

Well No. 1 Dreiling

Derby & Kiowa Company

FIRST REPORT

Contractor _____

NE SW

SECTION PLAT

330 Ft. from N. Line

_____ Ft. from S. Line

330 Ft. from E. Line

_____ Ft. from W. Line

		o	

Ellis County

Location X

Rig up _____

Drilling and Remarks:

RECORD

Cased _____ in., _____ ft.

Sand _____

Gas _____

Oil _____

Total Depth _____

PRODUCTION

1st 24 hrs. Nat. _____

1st 24 hrs. after shot _____

Gas _____ Cu. Ft.

Dry Hole _____

Abandoned _____

Date

APR 7 1948

19

S. J. LEWIS

Scout

Map No. 71 Sec. 3 Twp. 12 R. 16W

Well No. 1 Dreiling

Derby & Kiowa Company

ABANDONED

Contractor

NE SW

E. 1, 1809

SECTION PLAT

330 Ft. from N. Line

_____ Ft. from S. Line

330 Ft. from E. Line

_____ Ft. from W. Line

	0		

Ellis County

Location _____

Rig up _____

Drilling and Remarks:

OK 8367

RECORD

Cased _____ in., _____ ft.

Sand _____

Gas _____

Oil _____

Total Depth 3385

PRODUCTION

1st 24 hrs. Nat. _____

1st 24 hrs. after shot _____

Gas _____ Cu. Ft.

Dry Hole _____

Abandoned _____

Date

MAY 26 1948

19

S. J. LEWIS

Scout