


Section 5 Township 12 Range 16W

Well No. 1 Chrisler

Company Nadel & Gussman

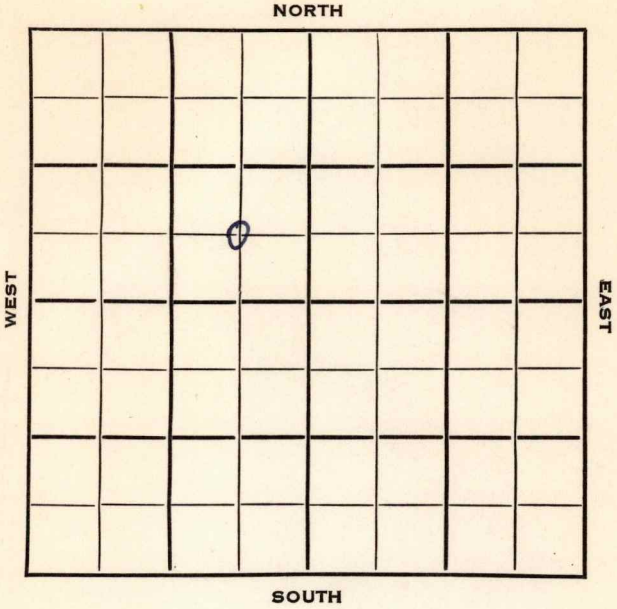


SEC. 5 TWP. 12 R. 16 W ✓

WELL NO. # 1 Chrisler FARM

COMPANY Nadel & Gussman

CONTRACTOR Nadel & Gussman

_____ Ft. from N. Line
 660 _____ Ft. from S. Line
 660 _____ Ft. from E. Line
 _____ Ft. from W. Line

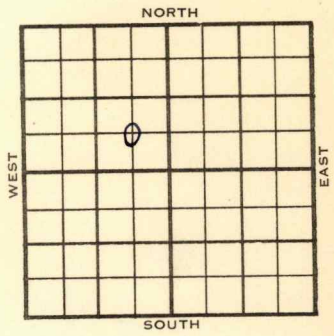

C S^E NW

1954 ELEVATION 1856' REPORT

2/17 MIR
 2/24 8" @ 209
 Drlg. 1415'
 3/3 Heeb 3036 Tor 3057 Lans 3082
 Drlg. 3400'
 3/10 Spud 2-18-54 D & A TD 3450
 8" @ 209 Heeb 3036 Tor. 3057
 Lans. 3082 B KC 3280 Cong. 3401
 TD 3450 D & A

ABANDONED

