


Section 4 Township 17 Range 13 <sup>KANSAS</sup> W

Well No. # 4 Drake (B)

Company N C R A

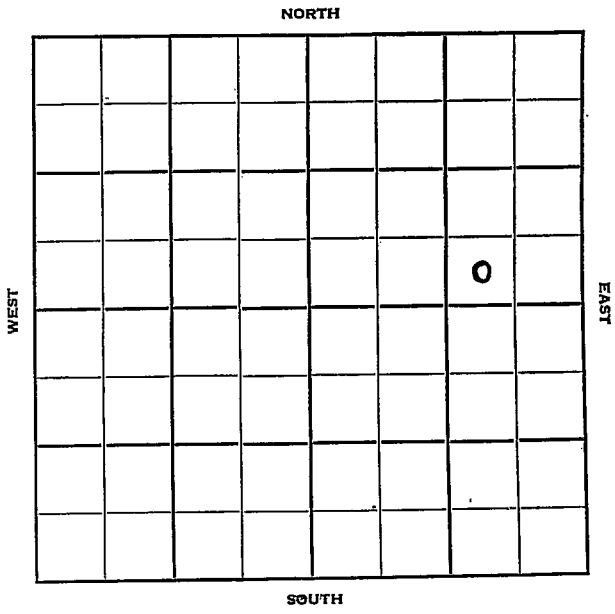

Sec. 4 Twp. 17 R. 13W

Well No. #4 Drake (B) Farm

N. C. R. A.

Company

Contractor

Ft. from N. Line

200'


Ft. from S. Line

950'

Ft. from E. Line

Ft. from W. Line

SW SE NE

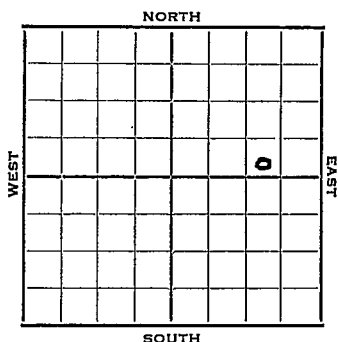

1952 Elev. 1913' REPORT

6/11

Spud 6-7-52

8" @ 254'

Drlg. 650'

6/18

Drlg. 3075'

6/25

Spud 6-7-52

D&A TD 3400' 8" @ 254'

Heeb. 3055

Tor. 3073

Br Li 3130

Lans. 3144

Cong. 3386

Arb. 3398


TD 3400

DST 3397-3400 open 2 hr. rec. 6' mud

D&A

**ABANDONED**

I. G. McGEHEE

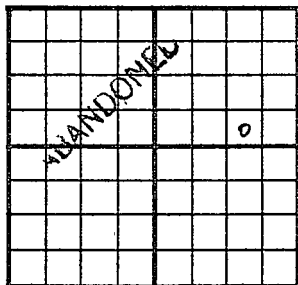County Barton State KansasSec. 4 (Blk.  
Twp.) 17 (Sur.  
Rge.) 13W Map No.Operator N C R AWell No. 4 Farm Drake "B"Elev. 1913. Location SW SE NE200 Ft. From S Line NE950 Ft. From E Line Quarter

1st. Report

Completion JUN 25 1952

Remarks

Spudding Date 6-7-52Drlg. Data D & A TD 34008" @ 254 Heeb. 3055 Tor. 3073Br. lime 3130 Lans. 3144 Cong. 3386Arb. 3398 TD 3400 DST 3397-3400open 2 hr. Rec. 6' mudD & A