


Russell
17 R. 15^W

Map No. _____ Sec. 19 Twp. _____ R. _____

Well No. 1-119 _____ Farm _____
Central Pet _____ Company _____

NORTH

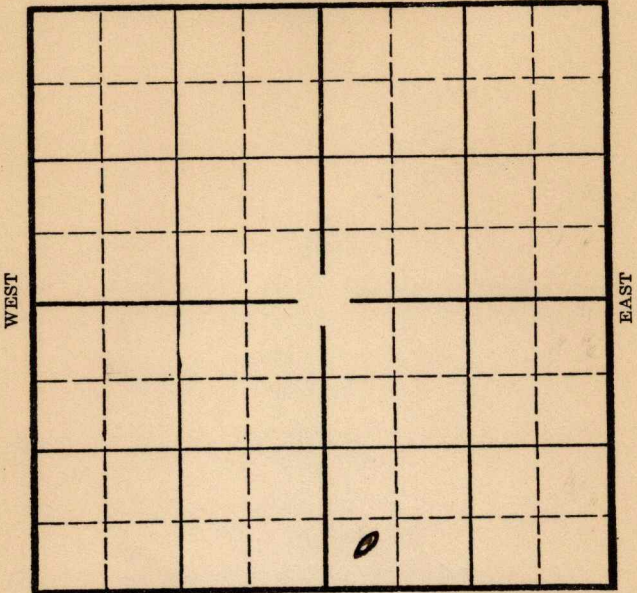

SOUTH

Location _____
Drilling Remarks _____

Rig Up _____
Drilling Remarks _____

RECORD

PRODUCTION

Cased _____ in. _____ ft.
Sand _____
Gas _____
Oil _____
Total Depth _____

1st 24 hrs. Nat. _____
1st 24 hrs. after shot _____
Gas _____ cu. ft. _____
Dry Hole _____
Abandoned _____

Russell

Map No. **KANSAS** Sec. 19 Twp. 12 R. 15W

Well No. 1- Gintner Farm
Central Pit Company


Ft. from N. Line

440 Ft. from S. Line

Ft. from E. Line

440 Ft. from W. Line

Elev. 1891

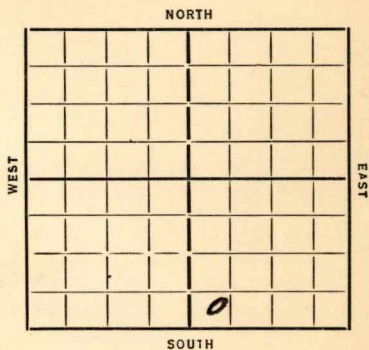

Date

REPORT

1935
6/19 Rig
6/28 7 1/2 -
7/11 dly 450
7/18 " 950
8/8 8" 2460 Ag 2465
Ag 2525 8" 2629
Lowering 8"
8/15 dly 3020
8/22 6" 3016 as 3047
HFV 3125-30
dly 3147
8/29 6" 3135 W 3147-57
WR 6" 3186
9/6 6" 3161 5" 3220
dly 3282
9/12 Oswald 3047
T 3376 HFV
75 FT.

ABANDONED

Map No. 72 Sec. 19 Twp. 12 R. 15W

Well No. 1 - Binther
Central Pet Company

Contractor

FIRST REPORTS

SECTION PLAT

..... Ft. from N. Line

440 Ft. from S. Line

..... Ft. from E. Line

440 Ft. from W. Line

RECORD

Location

Cased in., ft.

Rig up

Sand

Drilling and Remarks:

Gas

Rig

Oil

Total Depth

PRODUCTION

1st 24 hrs. Nat.

1st 24 hrs. after shot

Gas Cu. Ft.

Dry Hole

Abandoned

Date

ORVAL MANNSCHRECK

6-19-35 192

Scout

KANSAS

Map No. 72 Sec. 19 Twp. 12 R. 15W

Well No. 1 - Linther

Central Jet Company

Contractor

ABANDONED

SECTION PLAT

Ft. from N. Line

440 Ft. from S. Line

Ft. from E. Line

440 Ft. from W. Line

RECORD

Location

Rig up

Drilling and Remarks:

HFW

10 + H

Cased in., ft.

Sand Swell 3047

Gas

Oil

Total Depth 3376

PRODUCTION

1st 24 hrs. Nat.

1st 24 hrs. after shot

Gas Cu. Ft.

Dry Hole

Abandoned

Date

9-12-35 192

ORVAL MANNSCHRECK

Scout