


Section 7 Township 13 Range 17W

Well No. 2 C. Staab

Company Leo J. Dreiling

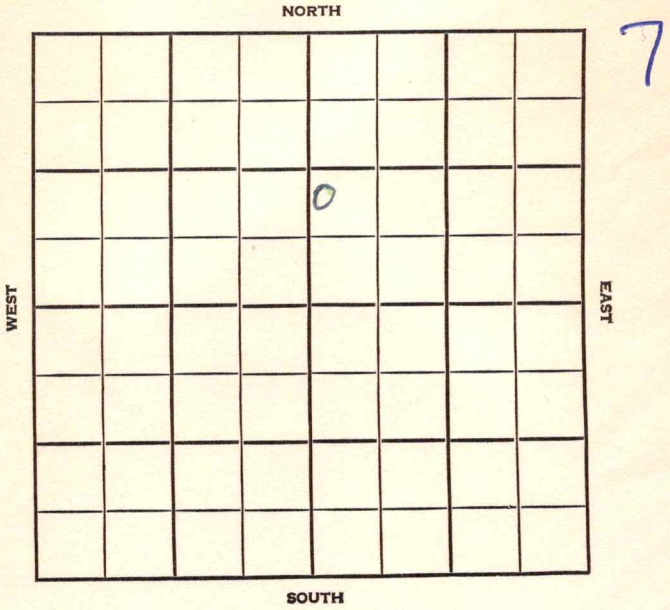

Ellis

KANSAS


SEC.	TWP.	R.
7	13	17W

WELL NO.
2 C. Staab FARM

COMPANY
Leo J. Dreiling

CONTRACTOR
Sidey Polifka

_____ Ft. from N. Line
 _____ Ft. from S. Line
 _____ Ft. from E. Line
 _____ Ft. from W. Line

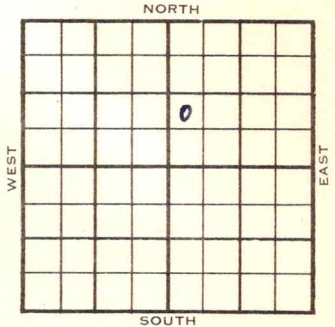

NW SW NE

1955	ELEVATION 2029'	REPORT
------	---------------------------	--------

6/15	Comm 6-13-55 8" @ 100/100 WOC	
8/10	Comm 6-13-55 A 3548 TD 3551 8" @ 100/100 5 1/2" @ 3548 Comp oil well	CO to 3558 Tite hole

COMPLETED

County Ellis Elev. _____
 Sec. 7 Twp. 13 Rge. 17W
 Company Leo J. Dreiling
 Farm Name C. Staab No. 2

TOPS	DEPTH	LOG	DATUM
Anh.			
Tp.			
H.			
Tr.			
Dg.			
Bl.			
L.			
K.C.			
B.K.C.			
Ce.			
C.			
M.			
M.			
K.			
Mz.			
Me.			
V.			
S.			
S.			
A.			
R.			
Pc.			
G.			
T.D.			

Loc. in Sec. NW SW NE

Geol. _____

Contr. _____

Sidney

Pool _____

Polifka

FIRST REPORT	
JUN 15 '55	

Date Comm. 6-13-55
8" @ 100/100 WOC

K-14

Co.

Lse.

No.

Sec.

T.

R.

County Ellis Elev. 2029
 Sec. 7 Twp. 13 Rge. 17W
 Company Leo. J. Dreiling
 Farm Name C. Staab No. 2

TOPS	DEPTH	LOG	DATUM	Loc. in Sec.																														
Anh.				NW SW NE																														
TP.																																		
H.																																		
Tr.																																		
Dg.																																		
Bl.				Geol.																														
L.				Contr.																														
K.C.				Sidey																														
B.K.C.				Pool																														
Ce.				Polifka																														
C.				<table border="1"> <tr><td></td><td></td><td></td></tr> <tr><td></td><td></td><td></td></tr> <tr><td></td><td></td><td></td></tr> <tr><td></td><td></td><td></td></tr> <tr><td></td><td></td><td></td></tr> <tr><td></td><td></td><td></td></tr> <tr><td></td><td></td><td></td></tr> <tr><td></td><td></td><td></td></tr> <tr><td></td><td></td><td></td></tr> <tr><td></td><td></td><td></td></tr> </table>																														
M.																																		
M.																																		
K.																																		
Mz.																																		
Me.																																		
V.																																		
S.																																		
S.																																		
A.	3548?		1579																															
R.																																		
PE.																																		
G.																																		
T.D.	3551?																																	

Date Comm. 6-13-55 AUG 10 1955
 8" @ 100/100 5½" @ 3548 CO to 3558
 Comp. oil well Tite hole

Co.
 Lse.
 No.
 Sec.
 T.
 R.

COMPLETE