

Sec. 4 Twp. 17 R. 13W

Well No. #4 ~~#5~~ Pelz Farm

Black-Marshall Company

Susank


330 Ft. from N. Line

_____ Ft. from S. Line

_____ Ft. from E. Line

660 Ft. from W. Line

C N L NW NW

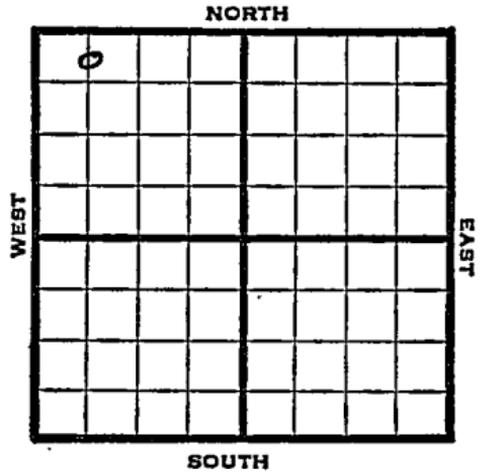

1947 Elev. 1910 REPORT

- 4/2 Surface hole.
- 4/9 8" @ 280'
Drlg 2465'
- 4/15 Arbuckle 3369-72' TD
5" @ 3371'
RUST
- 4/23 TD 3380'
Swb 40 bbls oil in 8 hrs
- 4/29 " " "
- 5/7 Arb 3369
5" @ 3371'
Pump 20 Pot
TD 3380'

COMPLETED

Susank Pool

Form 26-280 Bks. 10-46 Petrol
Kansas

Map No. 73 Sec. 4 Twp. 17 R. 13W

Well No. 5 Pelz

Black-Marshall Company

1ST REPORT Contractor

C N L NW NW

SECTION PLAT

o			

330 Ft. from N. Line

_____ Ft. from S. Line

_____ Ft. from E. Line

660 Ft. from W. Line

Barton County

Location _____

Rig up _____

Drilling and Remarks:

surface hole

RECORD

Cased _____ in., _____ ft.

Sand _____

Gas _____

Oil _____

Total Depth _____

PRODUCTION

1st 24 hrs. Nat. _____

1st 24 hrs. after shot _____

Gas _____ Cu. Ft.

Dry Hole _____

Abandoned _____

Date

APR 2 1947

S. J. LEWIS

Scout

Map No. K73 Sec. 4 Twp. 17 R. 13W

Well No. 4 Pelz

Black-Marshall

Company

CORRECTION

Contractor

C. N L NW NW

SECTION PLAT

330 Ft. from N. Line

_____ Ft. from S. Line

_____ Ft. from E. Line

660 Ft. from W. Line

o			

Barton County

RECORD

Location _____

Cased _____ in., _____ ft.

Rig up _____

Sand _____

Drilling and Remarks:

Gas _____

Reported as

Oil _____

#5 Pelz

Total Depth _____

PRODUCTION

1st 24 hrs. Nat. _____

1st 24 hrs. after shot _____

Gas _____ Cu. Ft.

Dry Hole _____

Abandoned _____

Date

APR 9 1947

19

S. J. LEWIS

Scout

Map No. k 73 Sec. 4 Twp. 17 R. 13W

Well No. 4 Pelz

Black-Marshall Company

COMPLETE

Contractor

C N L NW NW

E. I. 1910

SECTION PLAT

330 Ft. from N. Line

_____ Ft. from S. Line

_____ Ft. from E. Line

660 Ft. from W. Line

0			

Barton County

Location _____

Rig up _____

Drilling and Remarks:

CR 3369
5" 03871
Pump 20 PD

RECORD

Cased _____ in., _____ ft.

Sand _____

Gas _____

Oil _____

Total Depth 3380

PRODUCTION

1st 24 hrs. Nat. _____

1st 24 hrs. after shot _____

Gas _____ Cu. Ft.

Dry Hole _____

Abandoned _____

Date

MAY 7 1947

19

S. J. LEWIS Scout