

Sec. 7 Twp. 13 R. 17W ✓

Well No. #1 Polifka Farm _____


V. D. Sidey Company _____
Wildcat

_____ Ft. from N. Line

990' Ft. from S. Line

990' Ft. from E. Line

_____ Ft. from W. Line

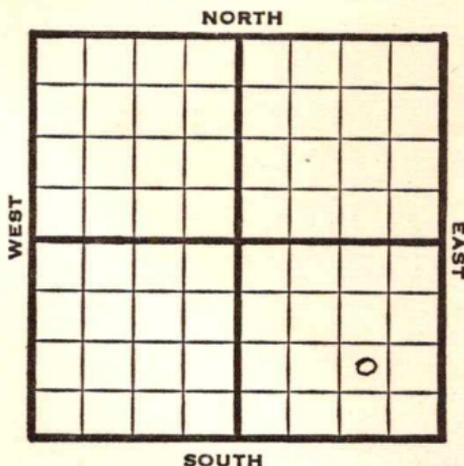

NW SE SE

1948

Eli 2102'

REPORT

9/8 Location

9/14 8"@ 250
Drlg 2400'

9/21 **Arb; 3639'-43'**
TD 3643'
5"@ 3640'

9/29 "

10/6 **Lansing 3385'**
TD 3671 SSO & W
Plug 3600'

10/13 "

10/19 "

10/26 "

11/3 "

11/10 TD 3671'

Arb. 3639'

5"@ 3640'

Pump 127 Oil / 3% W Pot

38° Gr.

Comp

COMPLETED

