


KANSAS Barton

Section 4 Township 17 Range 13-W

Well No. #2 Pelz

Company Black-Marshall

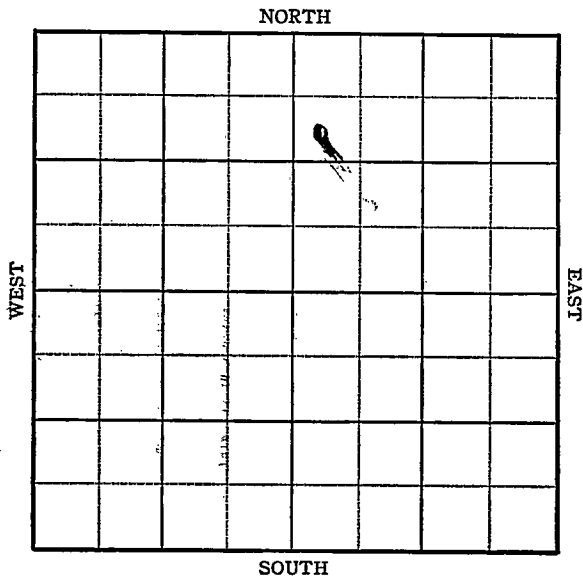

KANSAS

Barton County

Sec. 4 Twp. 17 R. 13W

Well No. #2 Pelz Farm

Black-Marshall

Company

Susank


990 Ft. from N. Line

 Ft. from S. Line

 Ft. from E. Line

330 Ft. from W. Line

SW NW NE

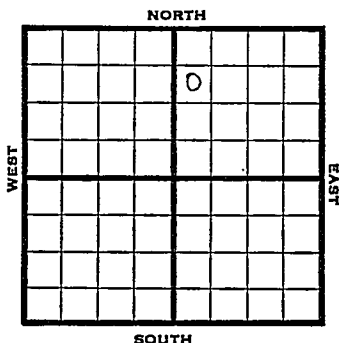

1946 Elev. 1934 REPORT

3/13 8" @ 264'
348'

3/21 Drlg. 3160'

4/4 Lans. 3162
Arb. 3398
5" @ 3398
TD 3402
Swb. $1\frac{1}{2}$ oil per hr.

4/10 " " "
4/16 " " "

4/24 Arb. 3398
5" @ 3398
TD 3402'
Pump 83 Pot.
Grav. 36.0

COMPLETED

Pool Name Susank


KANSAS Kansas

Map No. 73 Sec. 4 Twp. 17 R. 13WWell No. 2 PelzBlack-Marshall Company

FIRST REPORT Contractor

SW NW NE

SECTION PLAT

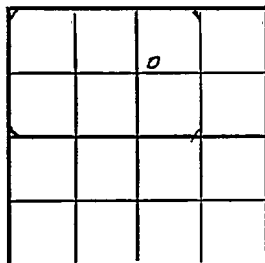990 Ft. from N. Line Ft. from S. Line Ft. from E. Line330 Ft. from W. LineBarton CountyLocation Rig up

Drilling and Remarks:

8" - 264348

RECORD

Cased in., ft.Sand Gas Oil Total Depth

PRODUCTION

1st 24 hrs. Nat. 1st 24 hrs. after shot Gas Cu. Ft.Dry Hole Abandoned

Date

MAR 13 1946 19S. J. LEWIS Scout

KANSAS


Kansas Pool Name SusankMap No. 73 Sec. 4 Twp. 17 R. 13WWell No. 2 PelzBlack-Marshall

Company

COMPLETED

Contractor

SW NW NE

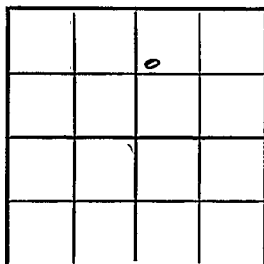E 1/1934
SECTION PLAT990 Ft. from N. Line Ft. from S. Line Ft. from E. Line330 Ft. from W. LineBarton CountyLocation Rig up

Drilling and Remarks:

Cr 733785" 23378Pump 8337836 2/3

RECORD

Cased in., ft.Sand Gas Oil Total Depth 3402

PRODUCTION

1st 24 hrs. Nat. 1st 24 hrs. after shot Gas Cu. Ft.Dry Hole Abandoned

Date

APR 24 194619S. J. LEWIS

Scout