

Ellis

FORM 51

KANSAS

Section 7 Township 13 Range 17W

Well No. #2 Rosy Staab

Company L. Dreiling

NORTH

WEST

EAST

SOUTH

11

0

Ellis

KANSAS

Sec. 7 Twp. 13 R. 17W ✓

Well No. #2 Rosy Staab Farm

L. Dreiling Company

Sidey Contractor

Wildcat.


990 Ft. from N. Line

_____ Ft. from S. Line

330 Ft. from E. Line

_____ Ft. from W. Line

SE NE SW

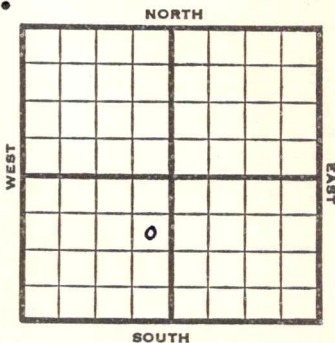

1953 **2123'** REPORT

8/19 Spud 8-18-53
8" @ 200'
Drlg.

8/26 Drlg 3003'

9/2 D & A

9/9 "

9/23 "

10/14 "

10/21 "

11/4 "

11/11 "

11/18 "

12/16 "

1954
1/20 D&A

2/3 Spud 8-18-53 D & A TD 3680
8" @ 200 **Anhy 1345 Heeb 3358**
Lans. 3404 Arb. 3650
TD 3680' D & A

ABANDONED

