

Section 8 Township 13 Range 17

Well No. #1 Leikam

Company Aylward & Blair

NORTH

		0					

3

WEST

EAST

SOUTH

Ellis

**KANSAS**

Sec. 8 Twp. 13 R. 17W

Well No. #1 Leikam Farm

Aylward & Blair Company

Contractor


330' Ft. from N. Line

Ft. from S. Line

990' Ft. from E. Line

Ft. from W. Line

NW NE NW

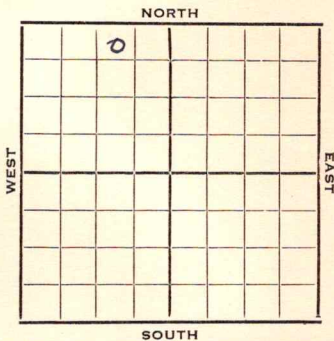

1951

**Elev. 2019'** REPORT

11/28  
12/12

RUR  
 Spud 11-27-51  
 D&A TD 3633  
 8" @ 125  
**Anhy 1250 Heeb. 3281**  
**KC 3331 B KC 3564**  
**Cong. 3586 ReArb. 3588**  
**Arb. 3602**  
 DST 3585-3605 open 45 min.  
 Rec. 15'mud TD 3633'  
 D&A

**ABANDONED**

County **Ellis** State **Kansas**

Sec. **8** (Blk. **13**) (Sur. **17**) Map No.

Operator **Aylward & Blair**

Well No. **1** Farm **Leikam**

Elev. Location **NW NE NW**

		0			

**330** Ft. From **N** Line **NW**

**990** Ft. From **E** Line **Quarter**

Ist. Report **NOV 28 1951**


Completion

Remarks

Spudding Date

Drlg. Data

**RUR**

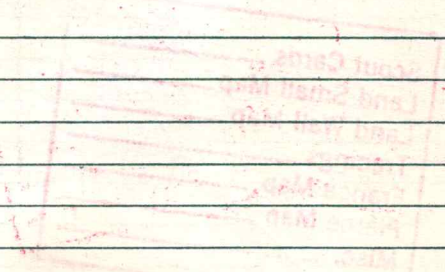

**J. E. TYRA**

County Ellis State Kansas

Sec. 8 (Blk. Twp.) 13 (Sur. Rge.) 17W Map No.

Operator Aylward & Blair

Well No. 1 Farm Leikam

Elev. 2019 Location NW NE NW

	0			

330 Ft. From N Line NW

990 Ft. From E Line Quarter

Ist. Report

Completion DEC 1 2 1951

Remarks

Spudding Date 11-27-51

Drlg. Data D & A TD 3633

8" @ 125 Anhy 1250 Heeb. 3281

KC 3331 B KC 3564 Cong. 3586

ReArb. 3588 Arb. 3602 DST 3585-3605

open 45 min. Rec. 15' mud TD 3633

D & A