

KANSAS

Ellis

Section 8 Township 13 Range 17W

Well No. 1 Staab

Company V.D. Sidey

Catherine
NORTH

6							

WEST EAST

SOUTH

12

KANSAS

Ellis

Sec. 8 Twp. 13 R. 17W ✓

Well No. #1 Staab Farm
V. D. Sidey Company

Catherine


990' Ft. from N. Line

 Ft. from S. Line

 Ft. from E. Line

330' Ft. from W. Line

SW NW SW

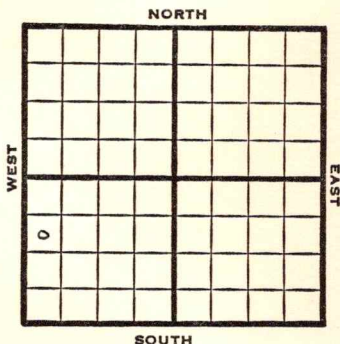

1949

Elev 2027'

R E P O R T

2/9 8" @ 153'
Drlg. 2352'

2/16 Drlg 3565'

2/23 "

3/2 "

3/8 "

3/16 "

3/23 TD 3616'

3/30 "

4/6 "

4/12 "

4/20 "

4/27 "

5/4 TD 3616'

Well not give out tops:
Aband.

ABANDONED

Kansas

Catherine

Map No. _____ Sec. 8 Twp. 13 R. 17 WWell No. 1 StarkV. D. Sides Company**FIRST REPORT** Contractor


S W N W S W

SECTION PLAT

990 Ft. from N. Line

_____ Ft. from S. Line

_____ Ft. from E. Line

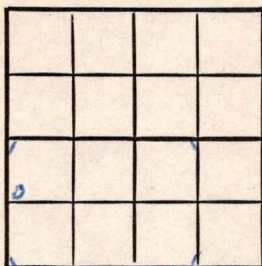330 Ft. from W. LineEllis

Location _____

Rig up _____

Drilling and Remarks:

8" @ 153'2352'

RECORD

Cased _____ in., _____ ft.

Sand _____

Gas _____

Oil _____

Total Depth _____

PRODUCTION

1st 24 hrs. Nat. _____

1st 24 hrs. after shot _____

Gas _____ Cu. Ft.

Dry Hole _____

Abandoned _____

Date

FEB 9 1949 19 S. J. LEWIS Scout

Kansas

Map No. K 71 Sec. 8 Twp. 13 R. 17WWell No. 1 StaabV. D. Sidey

Company

ABANDONED

Contractor

SW NW SW

E12027
SECTION PLAT

990 Ft. from N. Line Ft. from S. Line Ft. from E. Line330 Ft. from W. LineEllis CountyLocation Rig up

Drilling and Remarks:

*Will not give
out logs***RECORD**Cased in., ft.Sand Gas Oil Total Depth 3616**PRODUCTION**1st 24 hrs. Nat. 1st 24 hrs. after shot Gas Cu. Ft.Dry Hole Abandoned

Date

MAY 4 194919S. J. LEWIS

Scout