

Ellis

KANSAS

Section 9 Township 13 Range 17W

Well No. #1 A. A. Karlin

Company Texas Co.

NORTH

WEST

EAST

						0	

SOUTH

16

Ellis

KANSAS

Sec. 9 Twp. 13 R. 17W ✓

Well No. #1 A. A. Karlin Farm

Texas Co.

Company

Anschutz Drlg. - Contr.

Contractor

Catherine Pool

Ft. from N. Line

330'


Ft. from S. Line

990'

Ft. from E. Line

Ft. from W. Line

SW SE SE

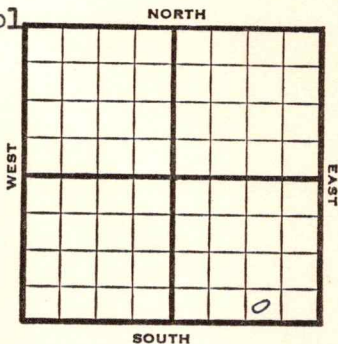

1950

Elev 2014'

REPORT

11/29

Location

12/20

Spud 12-1-50

13" @ 340

10" @ 1241

Heeb 3292

Lans 3338

DST 3517-27 opn 1 hr rec 15' mud

Cong 3585

TD 3657

D&A

ABANDONED

County Ellis State KansasSec. 9 (Blk. Twp.) 13 (Sur. Rge.) 17W Map No.Operator Texas CompanyWell No. 1 Farm A. A. KarlinElev. Location SW SE SE

FIRST REPORT

330 Ft. From S Line SE990 Ft. From E Line Quarter1st. Report NOV 29 1950

Completion


Remarks

Anschutz Drlg. - Contr.

Spudding Date

Drlg. Data Catherine PoolLocation

J. E. TYRA

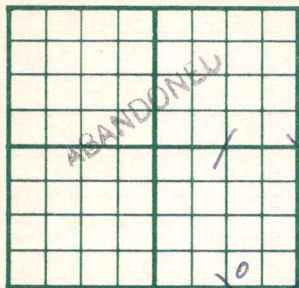County Ellis State KansasSec. 9 (Blk.) 13 (Sur.) 17W Map No. Operator Texas CompanyWell No. 1 Farm A.A. KarlinElev. 2014 Location SW SE SE330 Ft. From S Line SE990 Ft. From E Line Quarter1st. Report Completion DEC 20 1950Remarks Catherine PoolAnschutz Drlg. - Contr.Spudding Date 12-1-50Drlg. Data D & A TD 365713" @ 340 10" @ 1241 Heeb. 3292Lans. 3338 DST 3517-27 open 1 hr.Rec. 15' mud Cong. 3585 TD 3657D & A