

Ellis

KANSAS

SECTION 9 TOWNSHIP 13 RANGE 17 W

WELL NO. #1 A. A. Karlin

COMPANY R. W. Shields

NORTH

						0	

WEST

EAST

SOUTH

Ellis

KANSAS


SEC.	9	TWP.	13	R.	17W
------	---	------	----	----	-----

WELL NO. #1 A. A. Karlin FARM

COMPANY R. W. Shields

CONTRACTOR Barnett  
Catherine T/S

\_\_\_\_\_ Ft. from N. Line  
 \_\_\_\_\_ Ft. from S. Line  
 \_\_\_\_\_ Ft. from E. Line  
 \_\_\_\_\_ Ft. from W. Line

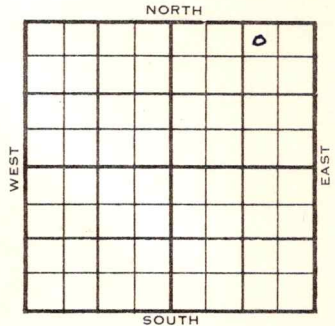

NW NE NE

CSO-FO

	ELEVATION	REPORT
--	-----------	--------

1955	2044'	
------	-------	--

11/9	Comm 11-5-55 8" @ 196 Anh Drlg 2083	1243
------	--	------

11-16	D & A TD 3634' Top: H. 3296 L. 3340 Shly 3589 Cong ch. 3607	
-------	--	--

ABANDONED

County Ellis Elev. \_\_\_\_\_  
 Sec. 9 Twp. 13 Rge. 17W  
 Company R. W. Shields  
 Farm Name A. A. Karlin No. 1

TOPS	DEPTH	LOG	DATUM
Anh.	1243		
Tp.			
H.			
Tr.			
Dg.			
Bl.			
L.			
K.C.			
B.K.C.			
Ce.			
C.			
M.			
M.			
K.			
Mz.			
Mq.			
V.			
S.			
S.			
A.			
R.			
Pe.			
G.			
T.D.			

Loc. in Sec. NW NE NE  
 Geol. \_\_\_\_\_  
 Contr. Barnett  
 Pool Catherine T/S

NOV 9 '55  
 FIRST REPORT

Date Comm. 11-5-55 CSO - FO  
8" @ 196 drlg. 2083

~~14~~

Co.  
Lse.  
No.  
Sec.  
T.  
R.

County Ellis Elev. 2044  
 Sec. 9 Twp. 13 Rge. 17W  
 Company R. W. Shields  
 Farm Name A. A. Karlin No. 1

TOPS	DEPTH	LOG	DATUM
Anh.	1243		
Tp.			
H.	3296		1252
Tr.			
Dg.			
Bl.			
L.	3340		1296
K.C.			
B.K.C.			
Ce.			
C. <i>shly.</i>	3589		1545
M. <i>Comp. sh.</i>	3607		1563
M.			
K.			
Mz.			
Mq.			
V.			
S.			
S.			
A			
R.			
PE.			
G.			
T.D.	3634		

Loc. in Sec. NW NE NE  
 Geol. \_\_\_\_\_  
 Contr. Barnett  
 Pool Catherine T/S



Date Comm. 11-5-55 NOV 16 1955  
8" @ 196

D & A

Co.  
Lse.  
No.  
Sec.  
T.  
R.