


Section 7 Township 13 Range 17 W

Well No. # 2 R. Staab

Company Continental Oil

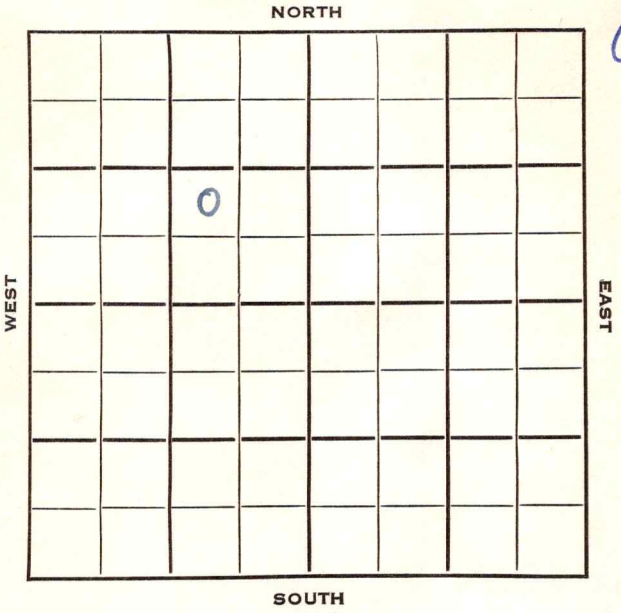

Ellis

KANSAS

SEC.	TWP.	R.
7	13	17W

WELL NO. #2 R. Staab FARM

COMPANY Continental Oil

CONTRACTOR Lohman & Johnson


Polifka Pool

_____ Ft. from N. Line

990 _____ Ft. from S. Line

990 _____ Ft. from E. Line

_____ Ft. from W. Line

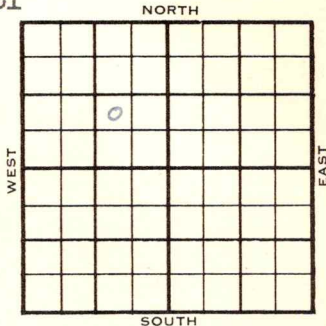

NW SE NW

1953	ELEVATION 2038'	REPORT
------	--------------------	--------

10/14 Spud 10-10-53
8" @ 170'
Drlg 2395'

10/21 Spud 10-10-53
D&A
TD 3609
8" @ 170
Heeb 3282, Lans 3332, Arb. 3588
TD 3609
D&A

ABANDONED

