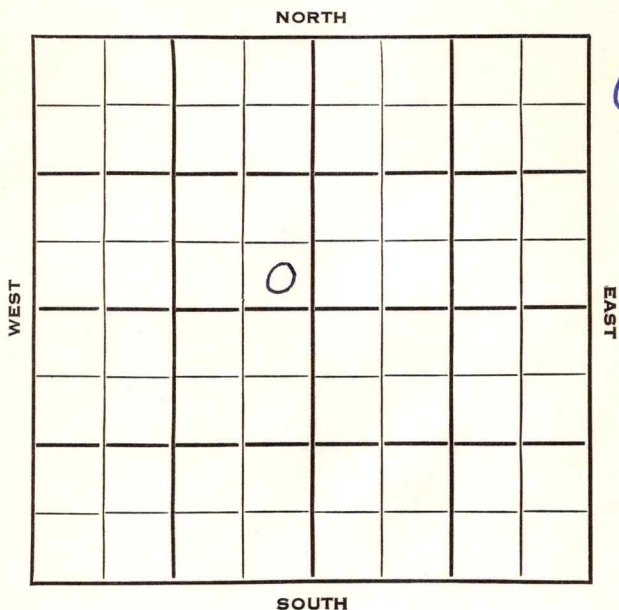


Section 7 Township 13 Range 17WWell No. #1 Rosy StaabCompany Continental Oil

Sec. 7 Twp. 13 R. 17WWell No. #1 Rosy Staab FarmContinental Oil

Company

L & J

Contractor


Polifka Pool

Ft. from N. Line

330 Ft. from S. Line330 Ft. from E. Line

Ft. from W. Line

SE SE NW

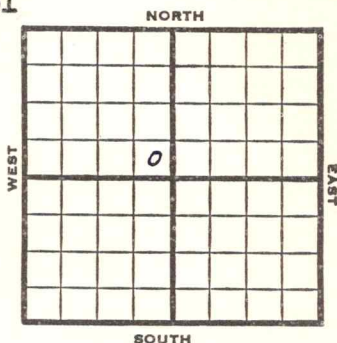

1953

Elev. 2049'

REPORT

8/19

Location

8/26

8" @ 237' w/125 sks

Anhy 1275

Drlg 2970'

9/2

Top 3028, Heeb 3266, Lans 3314

DST 3361-3407 1 hr, 120' Hly OCM, 570'

Hly gco 1000# Arb 3560

RTD 3564

5" @ 3559'

9/9

CO, testing

9/16

Spud 8-19-53 Oil well TD 3568

8" @ 237 Anhy 1275 Top 3028

Heeb 3266 Lans 3314

DST 3361-3407 open 1 hr rec 120' HOCM

570' HGCO 1000# Arb. 3560

TD 3564 5" @ 3559 CO to 3564

DD 3566 S/2½ BOPH 10 hr. DD 3568

S/4 BOPH 16 hr. 500 A

S/6½ BOPH 18 hr.

Comp. 261 BOPD

COMPLETED



J. G. McGEHEE