


Section 9 Township 13 Range 17-W

Well No. #1 Karlin

Company Texas Wildcat

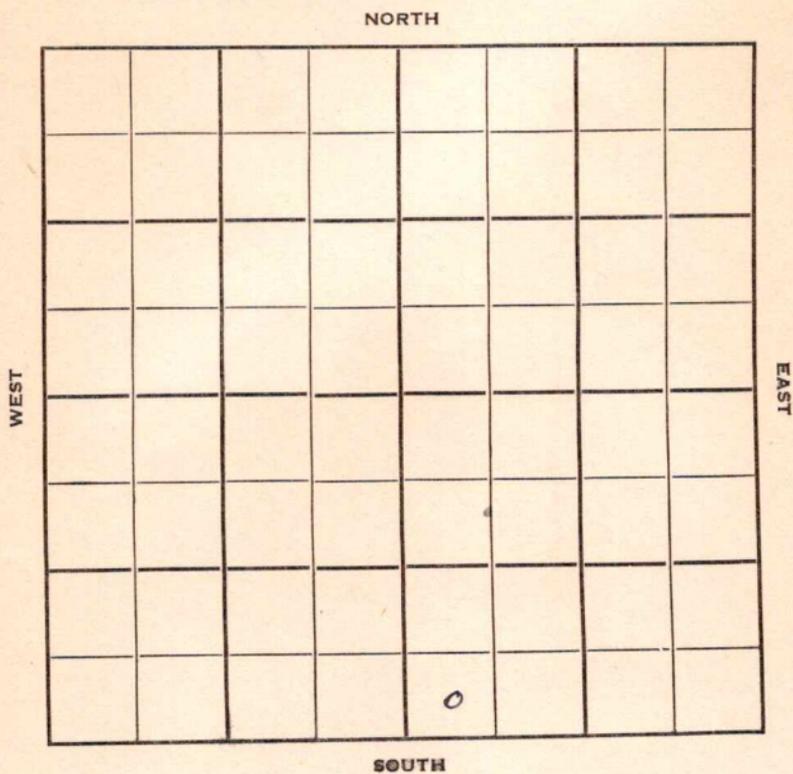

Ellis

KANSAS

Sec. 9 Twp. 13 R. 17W

Well No. #1 Karlin Farm  
Texas Company

Contractor Wilcoat


\_\_\_\_\_ Ft. from N. Line

330' Ft. from S. Line

\_\_\_\_\_ Ft. from E. Line

330' Ft. from W. Line

SW SE

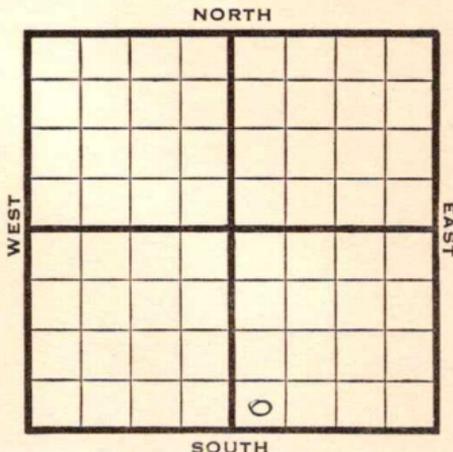

1949

**Elev 2021'** REPORT

10/26

**Anhy 1247'**  
8" @ 1257'

11/1

Drlg. 3215'

11/9

**Lansing 3334'**  
**Arbuckle 3582'**

TD 3587'  
5" @ 3585'

11/16

TD 3603'  
1000 acid  
Swb 2 1/3 bbls oil PH 8 hrs.

11/23

"

11/29

"

12/7

TD 3603'  
**Arb. 3582'**  
5"@ 3585'  
1000 acid  
Pump 144 Oil Pot  
25° Gr.  
Comp

**COMPLETED**

Map No. \_\_\_\_\_ Sec. 9 Twp. 13 R. 17W

Well No. 1 Karlin

\_\_\_\_\_ Texas \_\_\_\_\_ Company

\_\_\_\_\_ Contractor

SW SE

**FIRST REPORT  
SECTION PLAT**

\_\_\_\_\_ Ft. from N. Line

330 Ft. from S. Line

\_\_\_\_\_ Ft. from E. Line

330 Ft. from W. Line


\_\_\_\_\_ Ellis County

Location \_\_\_\_\_

Rig up \_\_\_\_\_

Drilling and Remarks:

Anhy 1247

8" @ 1257

**RECORD**

Cased \_\_\_\_\_ in., \_\_\_\_\_ ft.

Sand \_\_\_\_\_

Gas \_\_\_\_\_

Oil \_\_\_\_\_

Total Depth \_\_\_\_\_

**PRODUCTION**

1st 24 hrs. Nat. \_\_\_\_\_

1st 24 hrs. after shot \_\_\_\_\_

Gas \_\_\_\_\_ Cu. Ft.

Dry Hole \_\_\_\_\_

Abandoned \_\_\_\_\_

Date

OCT 26 1949

19

S. J. LEWIS

Scout

Kansas

Map No. \_\_\_\_\_ Sec. 9 Twp. 13 R. 17W

Well No. 1 Karlin

Texas \_\_\_\_\_ Company \_\_\_\_\_

COMPLETE

Contractor \_\_\_\_\_

SW SE

*21,202/*  
SECTION PLAT

\_\_\_\_\_ Ft. from N. Line

330 Ft. from S. Line

\_\_\_\_\_ Ft. from E. Line

330 Ft. from W. Line

		0	

Ellis County

Location \_\_\_\_\_

Rig up \_\_\_\_\_

Drilling and Remarks:

*Car 4352*  
*5" @ 3575*  
*10000 and*  
*Pump 144 oil Pat*  
*250 ft*

RECORD

Cased \_\_\_\_\_ in., \_\_\_\_\_ ft.

Sand \_\_\_\_\_

Gas \_\_\_\_\_

Oil \_\_\_\_\_

Total Depth 7603

PRODUCTION

1st 24 hrs. Nat. \_\_\_\_\_

1st 24 hrs. after shot \_\_\_\_\_

Gas \_\_\_\_\_ Cu. Ft.

Dry Hole \_\_\_\_\_

Abandoned \_\_\_\_\_

Date

DEC 7 1949 19

S. J. LEWIS Scout

29005T

O.W.W.O.

14

S-513-B

County Ellis Elev. \_\_\_\_\_  
 Sec. 9 Twp. 13 Rge. 17W  
 Company Texas  
 Farm Name Karlin No. 1

TOPS	DEPTH	LOG	DATUM
Anh.			
Tp.			
H.			
Tr.			
Dg.			
B.L.			
L.			
K.C.			
B.K.C.			
Ce.			
C.			
M.			
M.			
K.			
Mz.			
Mq.			
V.			
S.			
S.			
A.			
R.			
Pf.			
G.			
<del>OTD</del> OTD	3603		

Loc. in Sec. \_\_\_\_\_  
SW SW SE  
(O.W.W.O.)  
 Geol. \_\_\_\_\_  
 Contr. \_\_\_\_\_  
 Pool \_\_\_\_\_

**Bemis-Shutts**

**COMPLETE**  
**FIRST REPORT**  
 MAR 5 1938

Date Comm. \_\_\_\_\_  
 OLD INFO: OTD 3603, 5" @ 3585 was P 4 BO + 9 BW 24 hrs from Arb.  
 NEW INFO: MI, PB 3480, 32/3429-37 20/3418-23, 3000 Acid, P 118 BO + 6 BW/ 24 hrs.  
COMPLETE IPP 27 BO + 73% Wtr, Lans new producing horizon.

Co.  
Lse.  
No.  
Sec.  
T.  
R.