


# KANSAS

Ellis

Section 10 Township 13 Range 17W

Well No. #2 Giebler

Company Darby & Bothwell

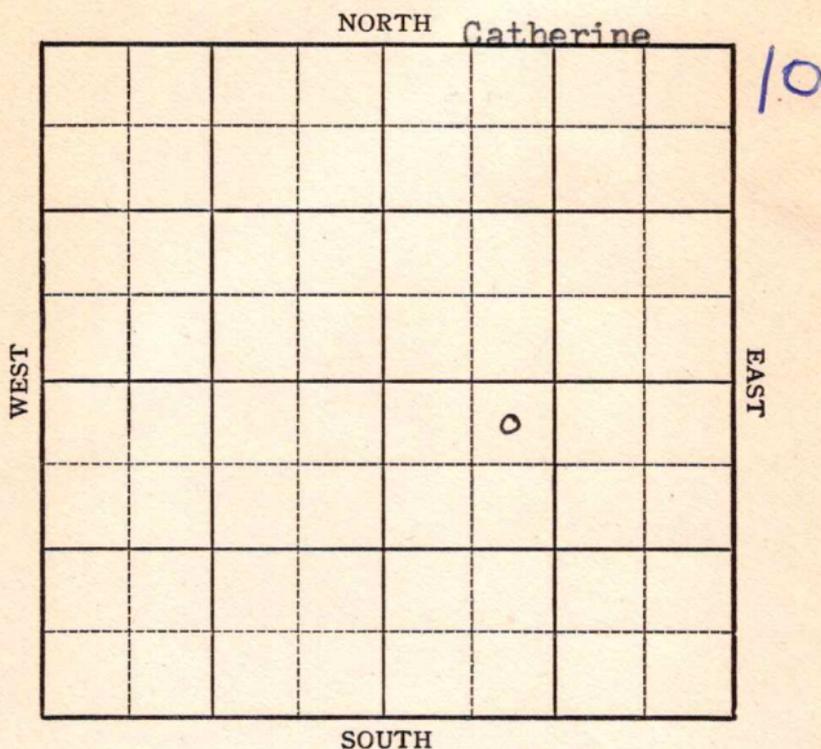

KANSAS

Ellis

Sec. 10 Twp. 13 R. 17W

Well No. #2 Giebler Farm

Darby & Bothwell

Company

Catherine Pool (Iron Drlg., Cont.)


330' Ft. from N. Line

\_\_\_\_\_ Ft. from S. Line

\_\_\_\_\_ Ft. from E. Line

990' Ft. from W. Line

NE NW SE

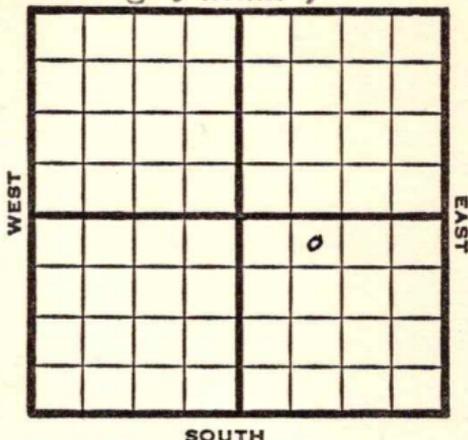

1949

**Elev. 2002'** REPORT

9/14

Anhy 1164'  
8" @ 1178'

9/21

Drlg. 3070'

10/5

Arb. 3506

5" @ 3507'

500 acid

Depth Pot. 3000 oil

27° Gr.

TD 3520'

Comp.

9/28

Lansing 3255'

Arb. 3506-08'

TD 3508'

5" @ 3507'

**COMPLETED**

Map No. \_\_\_\_\_ Sec. 10 Twp. 13 R. 17W

Well No. 2 Giebler

Darby & Bothwell Company

Iron Drlg. Contractor

NE NW SE


SECTION PLAT

330 Ft. from N. Line

\_\_\_\_\_ Ft. from S. Line

\_\_\_\_\_ Ft. from E. Line

990 Ft. from W. Line

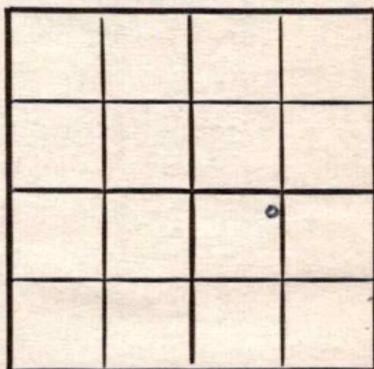

Ellis County

RECORD

Location \_\_\_\_\_

Cased \_\_\_\_\_ in., \_\_\_\_\_ ft.

Rig up \_\_\_\_\_

Sand \_\_\_\_\_

Drilling and Remarks:

Gas \_\_\_\_\_

Oil \_\_\_\_\_

Anhy 1164

Total Depth \_\_\_\_\_

8" © 1178

PRODUCTION

1st 24 hrs. Nat. \_\_\_\_\_

1st 24 hrs. after shot \_\_\_\_\_

Gas \_\_\_\_\_ Cu. Ft.

Dry Hole \_\_\_\_\_

Abandoned \_\_\_\_\_

Date

SEP 14 1949

19

S. J. LEWIS

Scout

Kansas

Map No. \_\_\_\_\_ Sec. 10 Twp. 13 R. 17W

Well No. 2 Giebler

Darby & Bothwell Company

COMPLETE Contractor

NE NW SE

E 12002  
SECTION PLAT

330 Ft. from N. Line

\_\_\_\_\_ Ft. from S. Line

\_\_\_\_\_ Ft. from E. Line

990 Ft. from W. Line

		o	

Ellis County

Location \_\_\_\_\_

Rig up \_\_\_\_\_

Drilling and Remarks:

*Cert 3506  
5" @ 3507  
500000  
Depth 3500 oil*

RECORD

Cased \_\_\_\_\_ in., \_\_\_\_\_ ft.

Sand \_\_\_\_\_

Gas \_\_\_\_\_

Oil \_\_\_\_\_

Total Depth *3520*

PRODUCTION

1st 24 hrs. Nat. \_\_\_\_\_

1st 24 hrs. after shot \_\_\_\_\_

Gas \_\_\_\_\_ Cu. Ft.

Dry Hole \_\_\_\_\_

Abandoned \_\_\_\_\_

Date

OCT 5 1949 19

S. J. LEWIS Scout