


Section 9 Township 13 Range 17W

Well No. #1 Karlin 'A' 11

Company G M R Oil

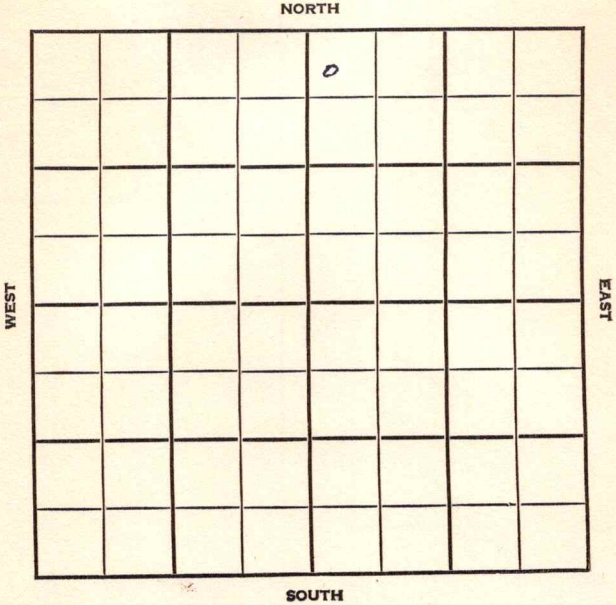

Ellis

KANSAS

SEC.	9	TWP.	13	R.	17 W
------	---	------	----	----	------

WELL NO. # 1 Karlin "A" FARM

COMPANY G-M-R Oil

CONTRACTOR


NW Kathryn

Ft. from N. Line

Ft. from S. Line

Ft. from E. Line

Ft. from W. Line

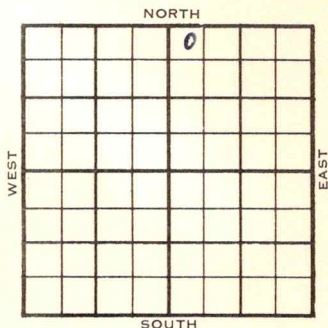

NW NW NE

	ELEVATION	REPORT
--	-----------	--------

1955

2047'

6/15

Comm. 4-30-55
 8-5/8" @ 201/120
 DST 3334-62 open 1 hr rec 30' SOCM
 180' muddy wtr, 940#
 DST 3405-16 open 1 hr rec 60' mud.
 110/20"
 DST 3564-3640 open 1 hr rec 150'
 muddy wtr. 0/20" 5 1/2" @ 3550
 CO to 3504 8/3408-11 B/4 ME GMC PH
 12/3402-04 B/4 GMOCW 500 A
 S/2 1/2 BOPH 2% wtr. P/13 BOPD
 TOPS: Anh. 1235', H. 3270', Tr. 3290'
 L. 3340', C. 3570'
 TD 3640'
 LOG: H. 3266, Tr. 3286, L. 3340',
 C. 3560'
 TD 3640'

FIRST REPORT



COMPLETED

County Ellis Elev. 2047 Co. 1
 Sec. 9 Twp. 13 Rge. 17W
 Company G-M-R Oil
 Farm Name Karlin "A" No. 1

TOPS	DEPTH	LOG	DATUM	Loc. in Sec.
Anh.	<u>1235</u>			NW NW NE
T.P.				
H.	<u>3270</u>	<u>3266</u>	<u>1219</u>	
Tr.	<u>3290</u>	<u>3286</u>	<u>1239</u>	
Dg.				Geol.
B.L.				
L.	<u>3340</u>	<u>3336</u>	<u>1289</u>	
K.C.				
B.K.C.				Contr.
Ce.				
C.	<u>3570</u>	<u>3560</u>	<u>1573</u>	
M.				
M.				Pool
K.				
Mz.				
Me.				
V.				NW Kathryn
S.				
S.				
A.				
R.				FIRST REPORT COMPLETE
Pc.	<u>52</u>		<u>1503</u>	
G.	<u>PP</u>		<u>1290</u>	
T.D.	<u>3640</u>		<u>1593</u>	

Date Comm. 4-30-55 JUN 15 1955
8 5/8" @ 201/120 DST 3334-62 open 1 hr.
Rec. 30' socm 180' muddy wtr. 940#
DST 3405-16 open 1 hr. Rec. 60' mud
110/20" DST 3564-3640 open 1 hr.
Rec. 150' muddy wtr. 0/20" 5 1/2" @ 3550
CO to 3504 8/ 3408-11 B/ 4 gmoph
12/ 3402-04 B/ 4 gmocw 500 A
S/ 2 1/2 boph 2% wtr. P/ 13 bopd