


Ellis

KANSAS

DX 78-1

Section 9 Township 13 Range 17W
Well No. #1 Schmidt
Company G-M-R Oil

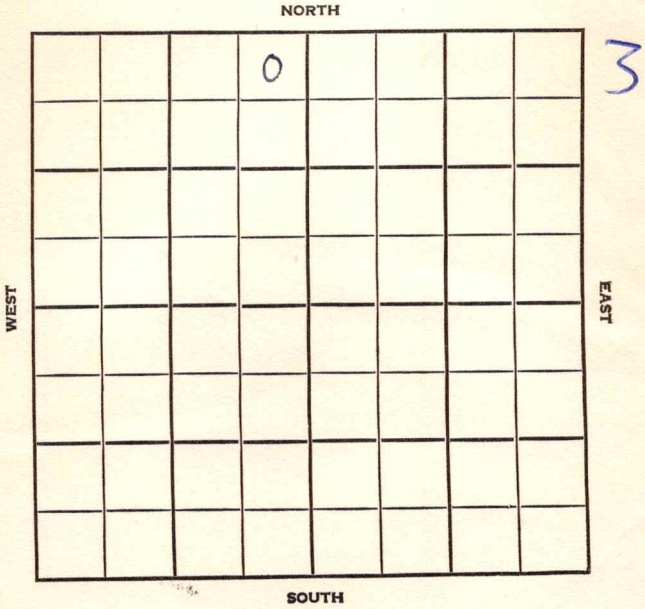

Ellis

KANSAS

SEC.	TWP.	R.
9	13	17W

WELL NO. #1 Schmidt FARM

COMPANY G-M-R Oil

CONTRACTOR Co. Tools.


NW Catherine Townsite.

330 Ft. from N. Line

Ft. from S. Line

330 Ft. from E. Line


Ft. from W. Line

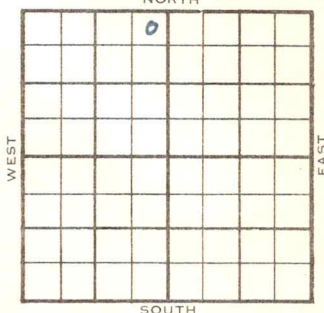

NE NE NW

	ELEVATION	REPORT
1955	2054'	
4/6	Spud 4-2-55 8" @ 1257' Drlg. 2058'	
6/1	Comm 4-2-55 8" @ 1257/450 DST 3336-65, open 1 hr. Rec 90' ocm 760/20", DST 3403-20 open 1 hr, Rec 210' gco, 1100' gas 410/20" 5½" @ 3588/185 CO to 3588 10' muddy oil, S/4 goph 250 A 4½ go 3% wtr. frac CO to 3584 20/3576-81 50 go 30% a B/2 goph H 3273, L. 3342, A 3547, TD 3592 250 A S/3.34 bfph 28% wtr, dec to 2.68 bfph 12 hr 24% wtr 1000 A frac S/4.17 bfph 26% wtr SP 3448 20/3406- 11 1000A S/25 BOPH 2% Wtr Comp 25 BOPD 2% wtr.	

COMPLETED

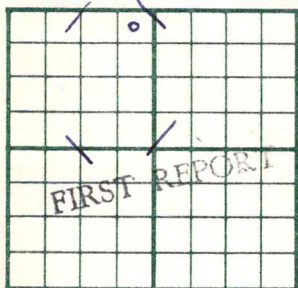County Ellis State KansasSec. 9 (Blk. Twp.) 13 (Sur. Rge.) 17W Map No. _____Operator G-M-R OilWell No. 1 Farm SchmidtElev. _____ Location NE NE NW330 Ft. From N Line NW330 Ft. From E Line Quarter1st. Report APR 6 1955

Completion _____

Remarks _____

Co. toolsSpudding Date 4-2-55Drlg. Data NW Catherine Townsite8" @ 1257 drlg. 2058

FABEN GILSTRAP

County Ellis Elev. 2054Sec. 9 Twp. 13 Rge. 17WCompany G-M-R OilFarm Name Schmidt No. 1

TOPS	DEPTH	LOG	DATUM	Loc. in Sec.
Anh.				NE NE NW
T.P.				
H.	3273		1219	
Tr.				
Dg.				Geol.
B.L.				
L.	3342		1288	
K.C.				
B.K.C.				Contr.
Ce.				Pool
C.				
M.				
M.				
K.				NW Catherine
Mz.				
Me.				
V.				
S.				
S.				
A.	3574		1520	
R.				
Pe.				COMPLETE
G.				
T.D.	3592			

Date Comm. 4-2-55 JUN 1 1955

8" @ 1257/450 DST 3336-65 open 1 hr.

Rec. 90' ocm 760/20" DST 3396-3403

open 1 hr. Rec. 30' vsocm DST 3403-20

open 1 hr. Rec. 210' gco 1100' gas


410/20" 5 $\frac{1}{2}$ " @ 3588/185 CO to 3588

10' muddy oil S/ 4 goph 250 A

4 $\frac{1}{2}$ go 3% wtr. frac CO to 3584

20/ 3576-81 50 go 30% a B/ 2 goph

250 A S/ 3.34 bfph 28% wtr. dec. to
2268 bfph 12 hr. 24% wtr. 1000 A
frac S/ 4.17 bfph 26% wtr. SP 3448
20/ 3406-11 1000 A S/ 25 boph 2% wtr.
Comp. 25 bopd 2% wtr.

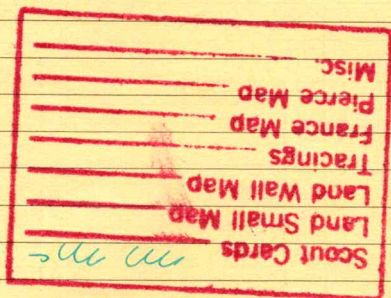

JUN 17 1955

720049