

Section 10 Township 13 Range 17W

Well No. #1 Dorzweiler

Company Anschutz Drlg.

NORTH

	0						

WEST

EAST

SOUTH

12

Ellis **KANSAS**

Sec. 10 Twp. 13 R. 17W

Well No. #1 Dorzweiler Farm ☒

Anschutz Drlg. Company

Anschutz - Contr. Contractor

Semi Wildcat


330' Ft. from N. Line

 Ft. from S. Line

 Ft. from E. Line

990' Ft. from W. Line

NE NW SW

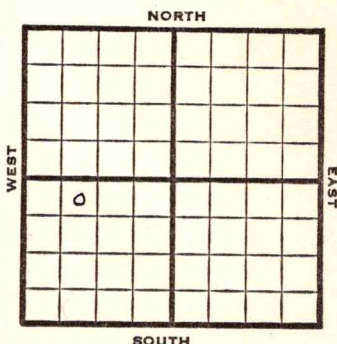

1951 **Elev. 2007'** REPORT

1/24 Spud 1-17-51
8" @ 244'
Anhy 1190'
Drlg. 2851'

4/11 Spud 1-17-51
D & A TD 3543'
8" @ 244' **Anhy 1190'** **Top. 2984'**
Heeb 3226' **Toronto 3248'** **Lans 3270'**
DST 3333-43' open 40 min. rec 10' mud
DST 3355-70 open 1 hr. rec 50' SW SSO
Arb. 3526-29, 5" @ 3527' TD 3538'
SSO 500 A B/6 GOPH DD 3540'
1500 A no inc. DD 3543'
B/1/2 BOPH 500 A S/ 15 BF 16 hr.
P/17 BO 18 BWPD SP 3474'
24/3404-12 500 A water
D & A

ABANDONED

County **Ellis** State **Kansas**
 Sec. **10** (Blk.) **13** (Sur.) **17W** Map No.

Operator **Anschutz Drlg.**

Well No. **1** Farm **Dorzweiler**

Elev. **2007** Location **NE NW SW**

FIRST REPORT

330 Ft. From **N** Line **SW**

990 Ft. From **W** Line **Quarter**

1st. Report **JAN 24 1951**

Completion

Remarks **Texas farmout**


Anschutz - Contr.

Spudding Date **1-17-51**

Drlg. Data **Semi Wildcat**

8" @ 244 Anhy 1190 drlg. 2851

J. E. TYRA

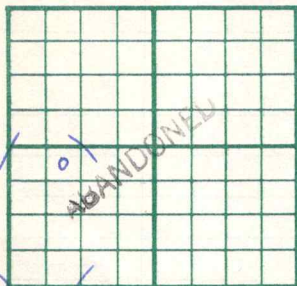County Ellis State KansasSec. 10 (Blk.) 13 (Sur.) 17W Map No.Operator Anschutz Drlg.Well No. 1 Farm DorzweilerElev. 2007 Location NE NW SW330 Ft. From N Line SW990 Ft. From W Line Quarter

1st. Report

Completion APR 11 1951Remarks Semi WildcatAnschutz Drlg. & Contr.Spudding Date 1-17-51Drlg. Data D & A TD 35438" @ 244 Anhy 1190 Top. 2984Heeb. 3226 Toronto 3248 Lans. 3270DST 3333-43 open 40 min. Rec. 10' mudDST 3355-70 open 1 hr. Rec. 50' sw SSOArb. 3526-29 5" @ 3527 TD 3538SSO 500 A B/ 6 goph DD 3540 1500Ano inc. DD 3543 B/ $\frac{1}{2}$ boph 500 AS/ 15 bf 16 hr. P/ 17 bo 18 bwpdSP 3474 24/ 3404-12 500 A waterD & A

J. E. TYRA