


Section 10 Township 13 Range 17W

Well No. #6 Giebler

Company Darby & Bothwell

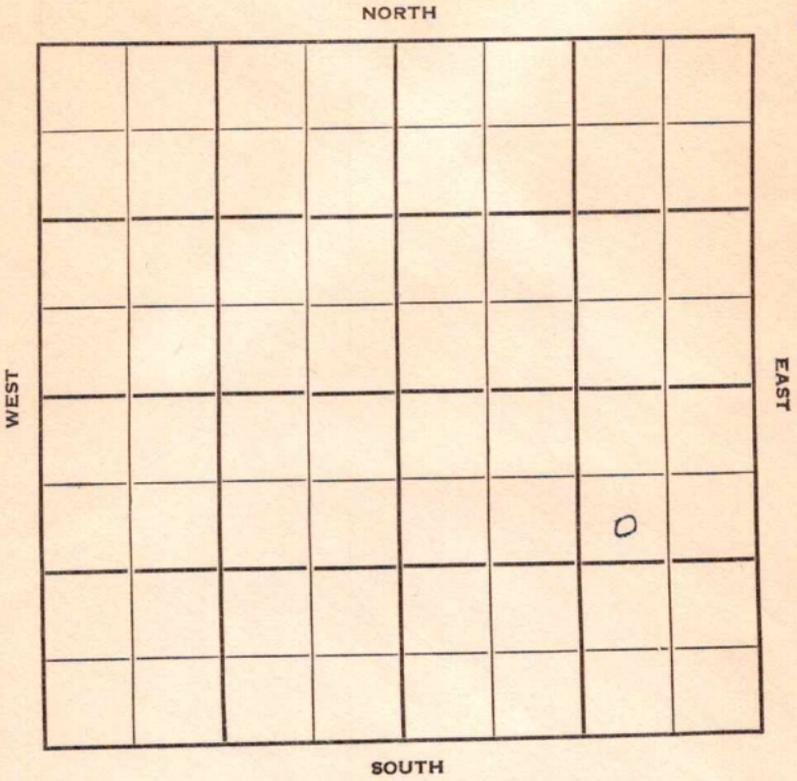

Ellis
13

17W

Sec. 10 Twp. 13 R. 17W

Well No. #6 Giebler Farm

Darby & Bothwell

Company

Catherine Pool


990' Ft. from N. Line

Ft. from S. Line

990' Ft. from E. Line

Ft. from W. Line

SW NE SE

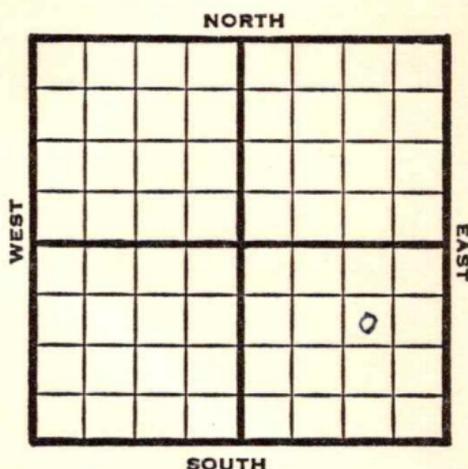

1950

Elev 1997'

REPORT

1/18

Spud 1-14-50

Anhy 1163'

8" @ 1173'

WOC

3/22

Anhy 1163'

8"@ 1173'

Topeka 2938'

Heebner 3201'

Lans 3246'

DST 3285-3320

opn 30 mins.

Rec 105' oil cut mud

DST 3320-50 opn 30 mins.

Rec 240' oil & gas cut mud

Arb. 3506'

5"@ 3507'

TD 3531'

SSO 3520'

15 shots 3515-31

15 shots 3505-12

Bail 31 Gal Oil 4 hrs.

1250 acid

Pump 133 B0 21 hrs.

Comp 59 Oil

11 wtr pd

Comp

COMPLETED

Map No. _____ Sec. 10 Twp. 13 R. 17W

Well No. 6 Giebler

Darby & Bothwell Company

Contractor

SW NE SE

SECTION PLAT

FIRST REPORT			
			0

990 Ft. from N. Line

_____ Ft. from S. Line

990 Ft. from E. Line

_____ Ft. from W. Line

Ellis County

Location _____

Rig up _____

Drilling and Remarks:

Spud 1-14-50

Anhy 1163

8" @ 1173

WOC

RECORD

Cased _____ in., _____ ft.

Sand _____

Gas _____

Oil _____

Total Depth _____

PRODUCTION

1st 24 hrs. Nat. _____

1st 24 hrs. after shot _____

Gas _____ Cu. Ft.

Dry Hole _____

Abandoned _____

Date

JAN 18 1950 19

J. E. TYRA

Scout

Map No. _____ Sec. 10 Twp. 13 R. 17W

Well No. 6 Giebler "B"

Darby & Bothwell Company

Contractor

SW NE SE

EI. 1997
SECTION PLAT

990 Ft. from N. Line

_____ Ft. from S. Line

990 Ft. from E. Line

_____ Ft. from W. Line

			0

COMPLETE

Ellis County

Location _____

Rig up _____

Drilling and Remarks:

anby 1163
8" @ 1173
Zopika 2938
Hebner 3201
Kans. 3246
DST 3285-3320
open 30 min
Rec. 105' oil cut mud

RECORD

Cased _____ in., _____ ft.

Sand _____

Gas _____

Oil _____

Total Depth _____

PRODUCTION

1st 24 hrs. Nat. _____

1st 24 hrs. after shot _____

Gas _____ Cu. Ft.

Dry Hole _____

Abandoned _____

Date

MAR 22 1950 19

J. E. TYRA

Scout

DST 3320-50 open 30 min

Rec. 240' oil + gas cut mud

arb. 3506

5" @ 3507

T.D. 3531

SSO 3520

15 shots 3515-31

15 " 3505-12

Bail 31 gal oil 4 hrs.

1250 Acid

Pump 133 lbs 21 hrs.

Comp 59 oil 11 water pd

Scout Cards
Land Small Map
Land Wall Map
Tracings
France Map
Pierce Map
Misc.

RECORD

SECTION 16.41

720037