

KANSAS


Section 10 Township 13 Range 17W

Well No. 1 Giebler "B"

Company Darby & Bothwell

Wildcat

NORTH

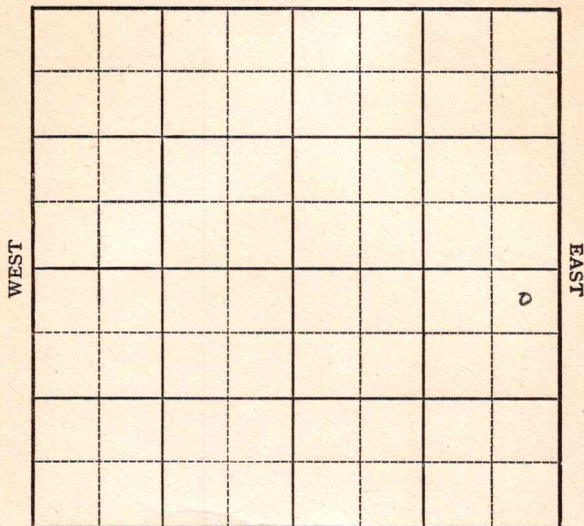

SOUTH

KANSAS

Ellis

Sec. 10 Twp. 13 R. 17W ✓

Well No. #1 Giebler "B" Farm

Darby & Bothwell Company

Wildcat


330' Ft. from N. Line

Ft. from S. Line

330' Ft. from E. Line

Ft. from W. Line

NE SE

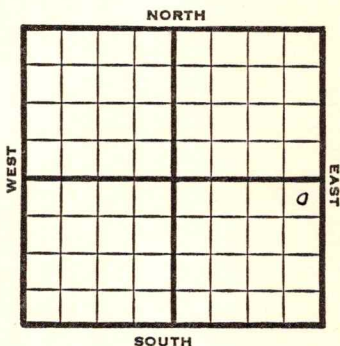

1949

Elev 2008' REPORT

3/23 Location
3/30 8"@ 234'
4/6 Drlg 2640'
4/12 **Lansing 3262'**
Arb. 3516-20'
TD 3520'
5"@ 3516'
4/20 TD 3542'
1500 acid
4/20 TD 3542'
Arb. 3516'
5"@ 3516'
1000 acid
Echo Pot 1301 Oil
27⁵ Gr.
Comp

COMPLETED

Kansas

Map No. _____ Sec. 10 Twp. 13 R. 17WWell No. 1 Giebler "B"Darby & Bothwell

Company

FIRST REPORT

Contractor

NE SE

330

Ft. from N. Line


Ft. from S. Line

330

Ft. from E. Line

Ft. from W. Line

SECTION PLAT

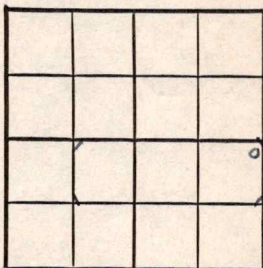Ellis CountyLocation X

Rig up _____

Drilling and Remarks:

RECORD

Cased _____ in., _____ ft.

Sand _____

Gas _____

Oil _____

Total Depth _____

PRODUCTION

1st 24 hrs. Nat. _____

1st 24 hrs. after shot _____

Gas _____ Cu. Ft.

Dry Hole _____

Abandoned _____

Date

MAR 23 194919S. J. LEWIS

Scout

Kansas

Map No. 271 Sec. 10 Twp. 13 R. 17WWell No. 1 Giebler "B"Darby & Bothwell

Company

COMPLETE

Contractor

NE SE

E1,2008
SECTION PLAT330 Ft. from N. Line Ft. from S. Line330 Ft. from E. Line Ft. from W. Line

			o

Ellis County

Location Rig up

Drilling and Remarks:

*Art 3516**5" @ 3516**1000 acid**Echo 20 x 100 oil**275/4***RECORD**Cased in., ft.Sand Gas Oil Total Depth 3542**PRODUCTION**1st 24 hrs. Nat. 1st 24 hrs. after shot Gas Cu. Ft.Dry Hole Abandoned

Date

APR 20 1949 19S. J. LEWIS

Scout