


Section 10 Township 13S Range 17W

Well No. #2 Karlin

Company Amerada

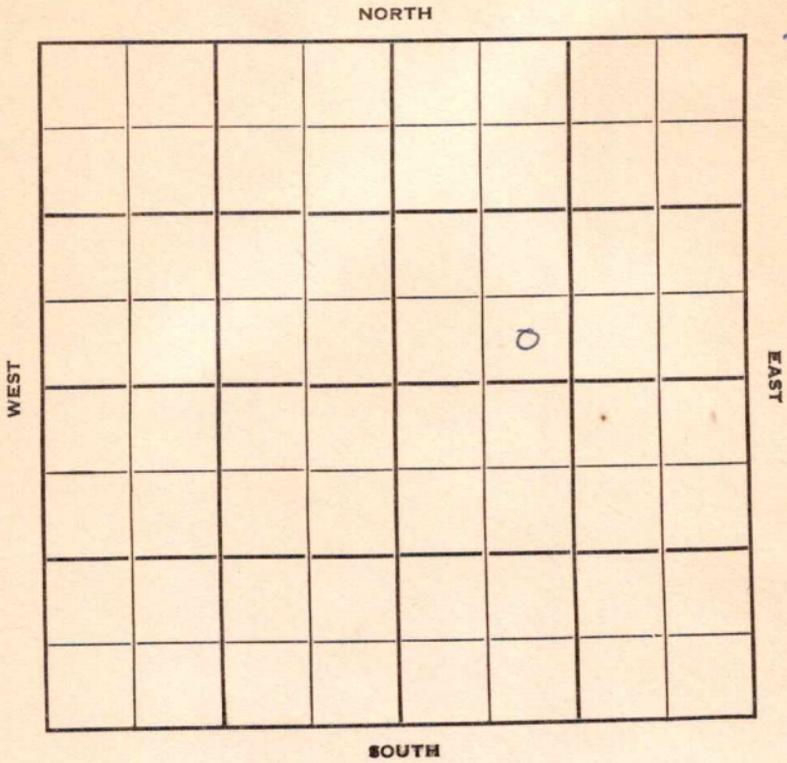

Sec. 10 Twp. 13 R. 17-W

Well No. #2 Karlin Farm _____

Amerada Company

Cont-- **Powell & Peters.**


Catherine

_____ Ft. from N. Line

330 Ft. from S. Line

_____ Ft. from E. Line

990 Ft. from W. Line

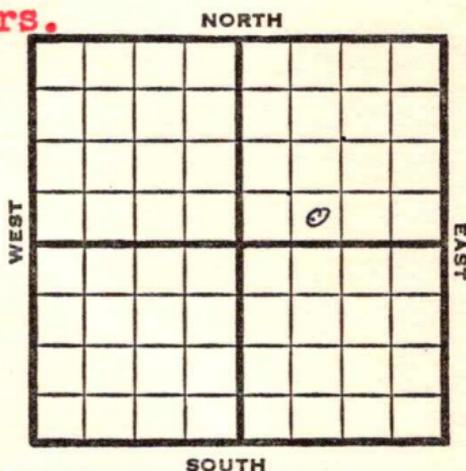

SE SW NE

1949

Elev. 2002' REPORT

10/12

Anhy 1154'
8" @ 1174'

10/19

Lansing 3257'
TD 3316'

10/26

Arbuckle 3506'
TD 3513'
5" @ 3509'

11/1

TD 3517'
Swb 180 bbls oil 8 1/4 hrs.

11/16

TD 3517'
Arb. 3506'
5" @ 3509'
Echo Pot 3000 Oil
27° Gr.
Comp

COMPLETED

Map No. _____ Sec. 10 Twp. 13 R. 17W

Well No. 2 Karlin

Amerada Company

Powell & Peters Contractor

SE SW NE

**FIRST REPORT
SECTION PLAT**

| | | | |
|--|--|--|--|
| | | | |
| | | | |
| | | | |
| | | | |
| | | | |

_____ Ft. from N. Line

330 Ft. from S. Line

_____ Ft. from E. Line

990 Ft. from W. Line

Ellis County

Location _____

Rig up _____

Drilling and Remarks:

Anhy 1154

8" @ 1174

RECORD

Cased _____ in., _____ ft.

Sand _____

Gas _____

Oil _____

Total Depth _____

PRODUCTION

1st 24 hrs. Nat. _____

1st 24 hrs. after shot _____

Gas _____ Cu. Ft.

Dry Hole _____

Abandoned _____

Date

OCT 12 1949 19

S. J. LEWIS Scout

Kansas

Map No. _____ Sec. 10 Twp. 13 R. 17W

Well No. 2 Karlin

Amerada Company

COMPLETE Contractor

SE SW NE

E1,2002

SECTION PLAT

_____ Ft. from N. Line

330 Ft. from S. Line

_____ Ft. from E. Line

990 Ft. from W. Line

| | | | |
|--|--|--|--|
| | | | |
| | | | |
| | | | |
| | | | |
| | | | |

Ellis County

Location _____

Rig up _____

Drilling and Remarks:

Cur 3006
510009
Ech 1000 oil

RECORD

Cased _____ in., _____ ft.

Sand _____

Gas _____

Oil _____

Total Depth 3517

PRODUCTION

1st 24 hrs. Nat. _____

1st 24 hrs. after shot _____

Gas _____ Cu. Ft.

Dry Hole _____

Abandoned _____

27 2/3

Date

NOV 16 1949

19

S. J. LEWIS

Scout