


Ellis

KANSAS

Section 10 Township 13 Range 17W

Well No. #3 Karlin

Company Amerada

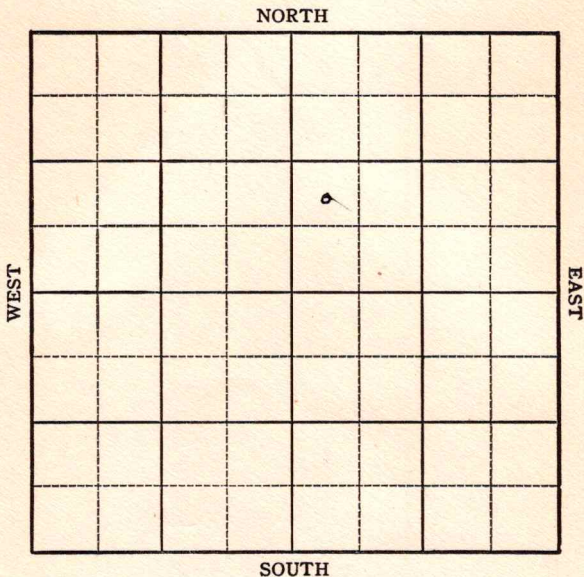

Ellis

Sec. 10 **KANSAS** Twp. 13 R. 17W ✓

Well No. #3 Karlin Farm

Amerada

Company

Powell & Peters

Contractor

Catherine Pool


Ft. from N. Line

990' Ft. from S. Line

Ft. from E. Line

330' Ft. from W. Line

NW SW NE

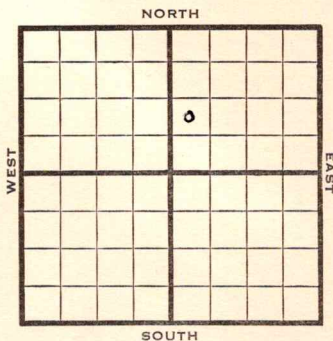

1949

Elev 2009'

REPORT

11/2	Location
11/9	RUR
11/16	8"@ 1192'
	Drlg 3050'
11/23	Lansing 3267'
	Arb. 3520-26'
	TD 3526'
	5"@ 3522'
11/29	TD 3538'
	2500 acid
12/7	Swb 4 bbls oil PH
12/14	"
12/21	"
12/28	"
1950	
1/18	TD 3538'
	8"@ 1192'
	5"@ 3522'
	PP 211 BOPD Tops;
	Anhy 1182'
	Heb 3220'
	Lans 3267'
	Arb. 3520'
	Comp
	COMPLETED

Map No. _____ Sec. 10 Twp. 13 R. 17W


Well No. 3 Karlin

Amerada Company

Powell & Peters Contractor

NW SW NE

FIRST REPORT
SECTION PLAT

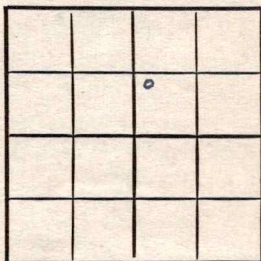

_____ Ft. from N. Line

990 Ft. from S. Line

_____ Ft. from E. Line

330 Ft. from W. Line

Ellis County

Location X

Rig up _____

Drilling and Remarks:

RECORD

Cased _____ in., _____ ft.

Sand _____

Gas _____

Oil _____

Total Depth _____

PRODUCTION

1st 24 hrs. Nat. _____

1st 24 hrs. after shot _____

Gas _____ Cu. Ft.

Dry Hole _____

Abandoned _____

Date

NOV 2 1949 19

S. J. LEWIS Scout

Kansas

Catherine Pool

Map No. _____ Sec. 10 Twp. 13 R. 17WWell No. 3 KarlinAmerada

Company

Contractor


NW SW NE

EL 2009
SECTION PLAT

_____ Ft. from N. Line

990 Ft. from S. Line

_____ Ft. from E. Line

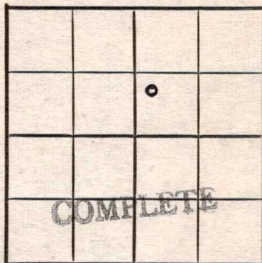330 Ft. from W. Line

COMPLETE

Ellis County

Location _____

Rig up _____

Drilling and Remarks:

8" @ 11925" @ 3522PP 211 B.O.P.D

Date

JAN 18 195019

RECORD

Cased _____ in., _____ ft.

Sand _____

Gas _____

Oil _____

Total Depth 3538

PRODUCTION

1st 24 hrs. Nat. _____

1st 24 hrs. after shot _____

Gas _____ Cu. Ft.

Dry Hole _____

Abandoned _____

J. E. TYRA

Scout

Ank 1182
Feb 3220
Jan. 3267
Ank. 3520



From N line

From S line

From E line

From W line

RECORD

Gas

Sand

Oil

Other

Notes

Scout Cards
Land Small Map
Land Wall Map
Tracings
France Map
Pierce Map
Misc.

JAN 20 1950