


Ellis

KANSAS

Section 10 Township 13 Range 17W

Well No. #4 Karlin

Company Amerada

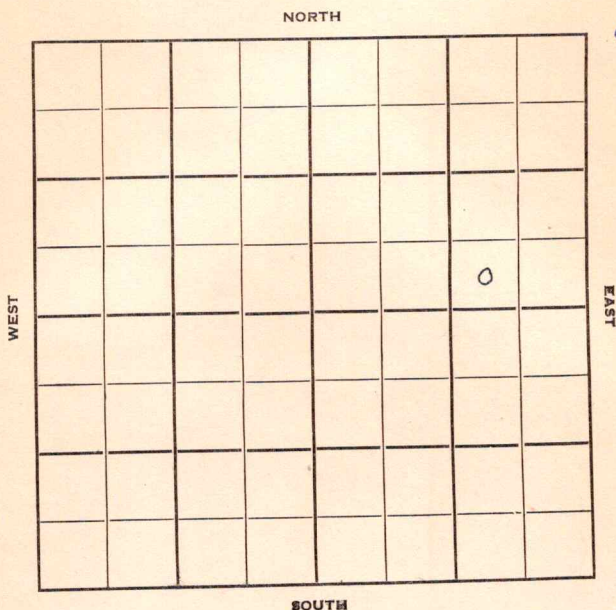

8

Ellis

KANSAS

Sec. 10 Twp. 13 R. 17W

Well No. #4 Karlin Farm

Amerada

Company

Catherine Pool (Howell-Peters, Contr.)


 Ft. from N. Line

330' Ft. from S. Line

990' Ft. from E. Line

 Ft. from W. Line

SW SE NE

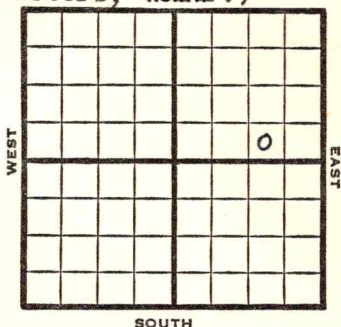

1949

Elev 2018'

REPORT

11/23 Surface Hole

11/29 8"@ 1196'

Drlg 2916'

12/7 Lansing 3267'

Arb. 3520-23'

TD 3523'

5"@ 3522'

12/14 295 shots 3234-70 -2000 acid

Swb 258 bbls oil 24 hrs.

12/21 "

12/28 "

1950

1/11 TD 3523'

8"@ 1196'

5"@ 3522'

Perf 298/3234-70

2000 acid

PP 575 BOPD

Anhy 1183'

Heeb 3222'

Lan 3267'

Arb. 3520'

Comp

COMPLETED

Map No. _____ Sec. 10 Twp. 13 R. 17W

Well No. 4 Karlin

Amerada Company

Howell, Peters Contractor

SW SE NE

FIRST SECTION PLAT

_____ Ft. from N. Line

330 Ft. from S. Line

990 Ft. from E. Line

_____ Ft. from W. Line

			0

Ellis County

Location _____

Rig up _____

Drilling and Remarks:

surface hole

RECORD

Cased _____ in., _____ ft.

Sand _____

Gas _____

Oil _____

Total Depth _____

PRODUCTION

1st 24 hrs. Nat. _____

1st 24 hrs. after shot _____

Gas _____ Cu. Ft.

Dry Hole _____

Abandoned _____

Date

NOV 23 1949 19

S. J. LEWIS Scout

Kansas

Map No. _____ Sec. 10 Twp. 13 R. 17WWell No. 4 Karlin

Amerada

Company

Contractor

SW SE NE

Elv. 2018
SECTION PLAT

COMPLETE			
			o

_____ Ft. from N. Line

330 Ft. from S. Line990 Ft. from E. Line

_____ Ft. from W. Line

Ellis County

Location _____

Rig up _____

Drilling and Remarks:

*8" @ 1196**5" @ 3522**Per 298/3234-70**2000 acid**PP 575 BOPD*

RECORD

Cased _____ in., _____ ft.

Sand _____

Gas _____

Oil _____

Total Depth _____

PRODUCTION

1st 24 hrs. Nat. _____

1st 24 hrs. after shot _____

Gas _____ Cu. Ft.

Dry Hole _____

Abandoned _____

Date

JAN 11 1950


19

J. E. TYRA

Scout

Ank 1183
 Hut 3222
 Lan 3267
 Ank 3520

SECTION PLAT

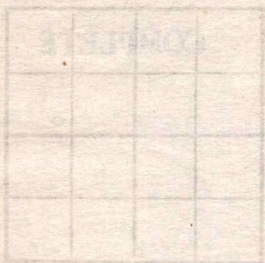

ft from N. line

ft from S. line

ft from E. line

ft from W. line

RECORD

Cased in _____
 Sand _____
 Gas _____
 Oil _____
 Total _____

Location

ft up

Drilling and Production

JAN 16 1950

Scout Cards _____
 Land Small Map _____
 Land Wall Map _____
 Tracings _____
 France Map _____
 Pierce Map _____
 Misc. _____

Date