

# KANSAS

Ellis

Section 10 Township 13S Range 17W

Well No. #4 Gieber "B"

Company Darby & Bithwell

NORTH

WEST

EAST

						o	

SOUTH

9

KANSAS

Sec. 10 Twp. 13 R. 17-W

Well No. #4 Giebler "B" Farm

Darby & Bothwell Company


Catherine

330 Ft. from N. Line

\_\_\_\_\_ Ft. from S. Line

990 Ft. from E. Line

\_\_\_\_\_ Ft. from W. Line

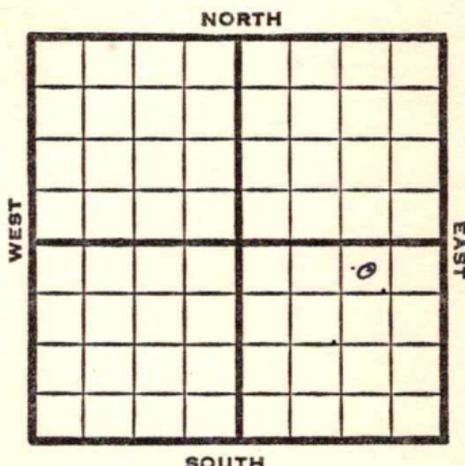

NW NE SE

1949 **Elev. 2007'** REPORT

10/12	Location
10/19	8" @ 1180' Drlg 1730'
10/26	Drlg. 3153'
11/1	<b>Lansing 3253'</b> <b>Arbuckle 3506'</b> TD 3508' 5" @ 3507'
11/9	"
11/16	TD 3508' <b>Lansing 3253'</b> <b>Arb. 3506'</b> 5" @ 3507' Perf Lans 1000 acid F Pump 918 Oil 32 <sup>9</sup> Gr. Comp

**COMPLETED**

Map No. \_\_\_\_\_ Sec. 10 Twp. 13 R. 17W

Well No. 4 Giebler "B"

Darby & Bothwell Company

Contractor

NW NE SE

FIRST REPORT  
SECTION PLAT

330 Ft. from N. Line

\_\_\_\_\_ Ft. from S. Line

990 Ft. from E. Line

\_\_\_\_\_ Ft. from W. Line

			o

Ellis County

Location X

Rig up \_\_\_\_\_

Drilling and Remarks:

RECORD

Cased \_\_\_\_\_ in., \_\_\_\_\_ ft.

Sand \_\_\_\_\_

Gas \_\_\_\_\_

Oil \_\_\_\_\_

Total Depth \_\_\_\_\_

PRODUCTION

1st 24 hrs. Nat. \_\_\_\_\_

1st 24 hrs. after shot \_\_\_\_\_

Gas \_\_\_\_\_ Cu. Ft.

Dry Hole \_\_\_\_\_

Abandoned \_\_\_\_\_

Date

OCT 12 1949 19

S. J. LEWIS

Scout

Map No. \_\_\_\_\_ Sec. 10 Twp. 13 R. 17W

Well No. 4 Giebler "B"

Darby & Bothwell Company

**COMPLETE**

Contractor

NW NE SE

*E. 2007*  
**SECTION PLAT**

330 Ft. from N. Line

\_\_\_\_\_ Ft. from S. Line

990 Ft. from E. Line

\_\_\_\_\_ Ft. from W. Line

			0

Ellis County

Location \_\_\_\_\_

Rig up \_\_\_\_\_

Drilling and Remarks:

*Lane 3253*  
*CR 3506*  
*5" CR 3507*  
*Prof Lane.*  
*1000 cu ft*  
*Prof. 9/18 oil*

**RECORD**

Cased \_\_\_\_\_ in., \_\_\_\_\_ ft.

Sand \_\_\_\_\_

Gas \_\_\_\_\_

Oil \_\_\_\_\_

Total Depth 3507

**PRODUCTION**

1st 24 hrs. Nat. \_\_\_\_\_

1st 24 hrs. after shot \_\_\_\_\_

Gas \_\_\_\_\_ Cu. Ft.

Dry Hole \_\_\_\_\_

Abandoned \_\_\_\_\_

Date

*329/49*

NOV 16 1949

19

S. J. LEWIS

Scout