

Section 10 Township 13 Range 17W
 Well No. #1 Karlin
 Company Derby & Bothwell

Catherine Pool

NORTH

			0				

WEST

EAST

SOUTH

6

Ellis

KANSAS

Sec. 10 Twp. 13 R. 17W

Well No. #1 Karlin Farm

Derby & Bothwell

Company


Catherine Pool (Iron Drlg., Co.)

Ft. from N. Line

330' Ft. from S. Line

330' Ft. from E. Line

Ft. from W. Line

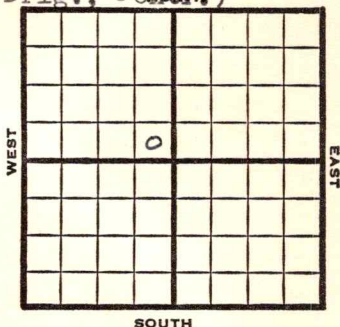

SE NW

1949

Elev 2017'

REPORT

12/14

Location

12/21

"

12/28

"

1950

5/3

TD 3548'

8 5/8" @ 1199'

Heeb 3233'

Lans 3280'

Arb. 3532'

5" @ 3532'

17 BOPD / 80% Wtr.

Comp

COMPLETED

Kansas

Map No. _____ Sec. 10 Twp. 13 R. 17W

Well No. 1 Karlin

Darby & Bothwell Company

Iron Drlg. Contractor

SE NW

FIRST REPORT SECTION PLAT

_____ Ft. from N. Line

330 Ft. from S. Line

330 Ft. from E. Line

_____ Ft. from W. Line

Ellis County

Location X

Rig up _____

Drilling and Remarks:

RECORD

Cased _____ in., _____ ft.

Sand _____

Gas _____

Oil _____

Total Depth _____

PRODUCTION

1st 24 hrs. Nat. _____

1st 24 hrs. after shot _____

Gas _____ Cu. Ft.

Dry Hole _____

Abandoned _____

Date

DEC 14 1949 19

S. J. LEWIS Scout

Kansas

Map No. _____ Sec. 10 Twp. 13 R. 17W

Well No. 1 Karlin

Darby & Bothwell Company

Contractor

SE NW

E.I. 2017
SECTION PLAT

_____ Ft. from N. Line

330 Ft. from S. Line

330 Ft. from E. Line

_____ Ft. from W. Line

COMPLETE			
	0		

Ellis County

Location _____

Rig up _____

Drilling and Remarks:

8 5/8 @ 1199
Hub 3233
Lans 3280
Arb 3532
5" @ 3532

RECORD

Cased _____ in., _____ ft.

Sand _____

Gas _____

Oil _____

Total Depth 3548

PRODUCTION

1st 24 hrs. Nat. _____

1st 24 hrs. after shot _____

Gas _____ Cu. Ft.

Dry Hole _____

Abandoned _____

Date 17 BOPD + 80% NAT.

MAY 3 1950

19

J. E. TYRA Scout