


Section 8 Township 17 Range 11W

Well No. #2 Radenberg "B"

Company Ogden Brothers

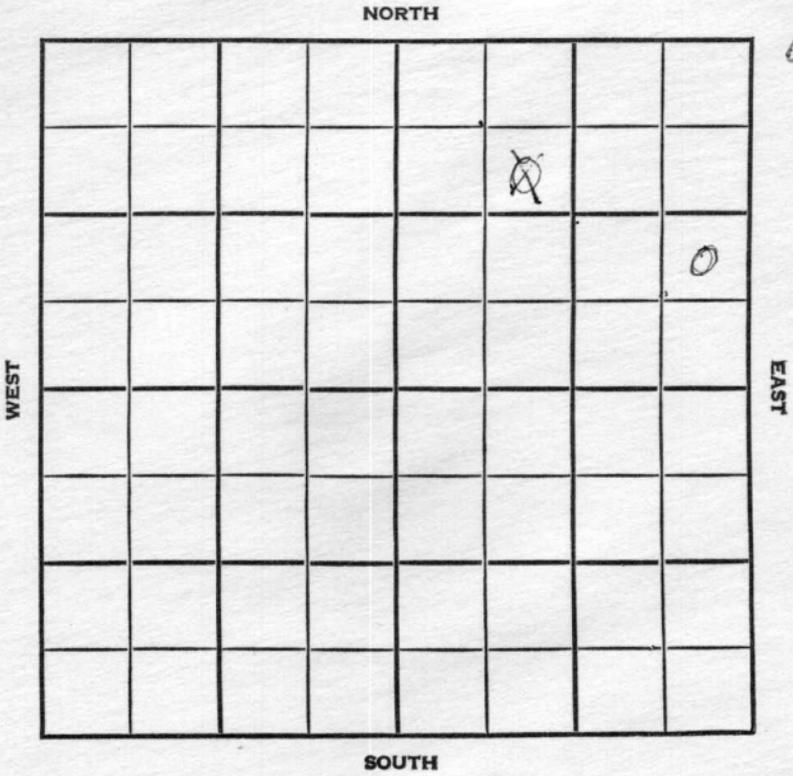

County Barton Elev. _____
 Sec. 8 Twp. 17 Rge. 11W
 Company Ogden Brothers
 Farm Name Radenberg No. 2

TOPS	DEPTH	LOG	DATUM	Loc. in Sec.						
Anh.				SE NW NE						
TP.										
H.										
Tr.										
Dg.										
Bl.										
L.				Geol. _____						
K.C.				Contr. _____						
B.K.C.				Sierra Tools						
Ce.										
C.				Pool						
M.				Kraft-Prusa						
M.				<table border="1"> <tr> <td></td> <td></td> <td></td> </tr> <tr> <td></td> <td>NOV 14 '56</td> <td></td> </tr> </table>					NOV 14 '56	
	NOV 14 '56									
K.										
Mz.				FIRST REPORT						
Me.										
V.										
S.										
S.										
A.										
R.										
PE.										
G.										
T.D.										

Date Comm. _____

MIRT

NOV 5 0 1956

R.G.

Co.

Use

No.

Sec.

T.

R.

CORRECTION

FORM 513 SUNRAY

County Barton Elev. 1851
 Sec. 8 Twp. 17 Rge. 11W
 Company Ogden Brothers
 Farm Name Radenberg "B" No. 2

TOPS	DEPTH	LOG	DATUM	Loc. in Sec.						
Anh.	678			SE NW NE 1500 FVL 50' FEL OF SEC NE SE NE						
Tp.	Tark	2378								
H.	TP	2626								
Tr.	Hg	2916								
Dg.	Tr	2933								
Bl.	Dg	2948		Geol.						
L.	BL	3018		Concr.						
K.C.	659	3023		Ce.						
B.K.C.				C.						
M.				M.						
M.				Pool						
K.				Kraft-Prusa						
Mz.				<table border="1" style="width: 100%; height: 100%; border-collapse: collapse;"> <tr> <td style="width: 50%;"></td> <td style="width: 50%; text-align: center;">o</td> </tr> <tr> <td style="width: 50%;"></td> <td style="width: 50%; text-align: center;">DEC 26 '56</td> </tr> <tr> <td colspan="2" style="text-align: center; font-size: 2em; font-weight: bold;">COMPLETE</td> </tr> </table>		o		DEC 26 '56	COMPLETE	
	o									
	DEC 26 '56									
COMPLETE										
Ma.										
V.										
S.										
S.										
A.		3297								
R.										
PE.										
G.										
TD.		3329								

Date Comm. MIRT NOV 21 '56 11-13-56 8 5/8 207
11 30 5 NOV 28 '56 DST 2037-51 30"
25' Md BHP 0 DST 3300-05 30"
8' Md BHP 210/20 DST 3301-11
30" 15' 50 EM BHP 0 5 1/2 c
3328/100 DEC 5 '56 MICT DEC 12 '56 00
3320 32/3302-10 A.S. 20 Goph
no time 13 DEC 19 '56 DEC 26 '56 1st
part hd PF 3315-20 S.I. 12 hrs

Co. No. Sec. T. R.

A. 4 Boph no/wtr Pop
P. 25 Bopd no/wtr.