

Map No. **KANSAS** Sec. 13 Twp. 29 R. 9


M^e Sullivan et al Company

NORTH

WEST

EAST

SOUTH

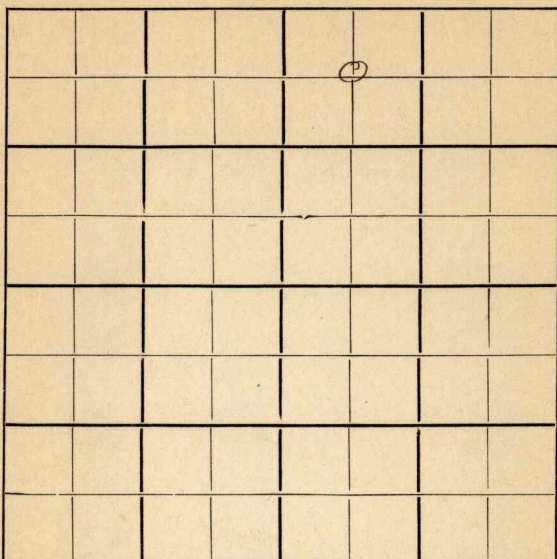

Location.....

Rig Up.....

Drilling Remarks

Drilling Remarks

.....

.....

RECORD

PRODUCTION

Cased..... in..... ft.

1st 24 hrs. Nat.....

Sand.....

1st 24 hrs. after shot.....

Gas.....

Gas..... cu. ft.....

Oil.....

Dry Hole.....


Total Depth.....

Abandoned.....

Map No. **KANSAS** Sec. 13 Twp. 29 R. 9

Well No. 1-2 Dunlap Farm
M. Sullough Oil Company

660 Ft. from N. Line
 Ft. from S. Line
 Ft. from E. Line
660 Ft. from W. Line

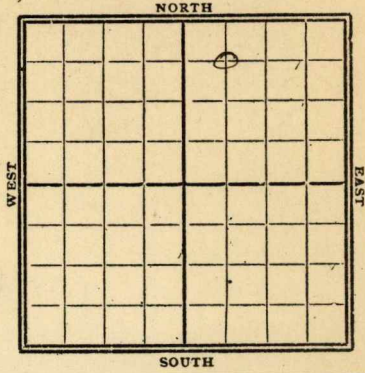

1928

Date REPORT

Date	REPORT
10/24	Rigging up.
10/31	Spudded 40' + S.D.
11/7	Drlg 450'
11/14	S.D. 450' for water
11/21	_____
11/28	Drlg 700'
12/5	" 860'
12/12	S.D. 873'
12/19	drlg 1000'
12/26	" 1000'
1929	
1/2	S.D. 1575'
1/9	S.D. 1600'
1/16	drlg 1800'
1/23	" 2130'
1/30	Top line 2238'
	S.D. 2262' show oil
2/6	_____
2/13	_____
2/20	sho O & G. & HFW 2270 '
	S.D. 2262'
2/27	_____

3/6 Top line 2236 - show oil
and HFW S.D. 2262'

3/13 ———

3/20 ———

3/27 ———

4/3 Top line 2236'
TD. 2268'
Dry & abandon

K10 KANSAS

MAP No. _____ SEC. 13 TWP. 29 R. 9

WELL No. 10 Dunlap

Mc Cullough Oil Co COMPANY

CONTRACTOR

FIRST REPORTS

SECTION PLAT

660 FT. FROM N. LINE

_____ FT. FROM S. LINE

_____ FT. FROM E. LINE

660 FT. FROM W. LINE

		0	

LOCATION _____

RIG UP _____

DRILLING AND REMARKS:

Rigging up

RECORD

CASED _____ IN., _____ FT.

SAND _____

GAS _____

OIL _____

TOTAL DEPTH _____

PRODUCTION

1ST 24 HRS. NAT. _____

1ST 24 HRS. AFTER SHOT _____

GAS _____ Cu. Ft.

DRY HOLE _____

ABANDONED _____

DATE

OCT 24 1928

CHAS. L. SHERWOOD

192

SCOUT

Map No. **KANSAS** Sec. *13* Twp. *29* R. *9*

Well No. *1* *Dunlap*

McCullough Oil Co Company

Contractor

COMPLETE

SECTION PLAT

660 Ft. from N. Line

..... Ft. from S. Line

..... Ft. from E. Line

660 Ft. from W. Line

		0	

ABANDONED

Location.....

Rig up.....

Drilling and Remarks:

Top line 2236

2268

RECORD

Cased..... in., ft.

Sand.....

Gas.....

Oil.....

Total Depth *2268'*

PRODUCTION

1st 24 hrs. Nat.....

1st 24 hrs. after shot.....

Gas..... Cu. Ft.

Dry Hole

Abandoned

Date

APR 3 1929

CHAS. L. SHERWOOD

192.....

Scout