


Section 10 Township 33 Range 3E

Well No. #2 Wright

Company Crest Petroleum Co.

NORTH

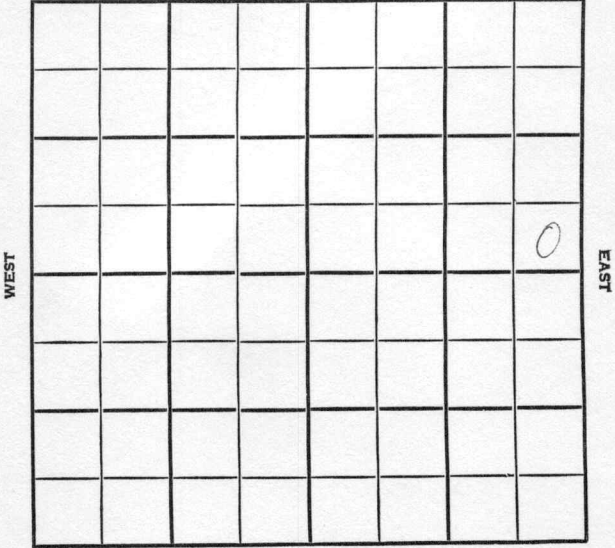

SOUTH

WEST

EAST

County Cowley Elev. \_\_\_\_\_  
 Sec. 10 Twp. 33 Rgs. 3E  
 Company Crest Petroleum Co.  
 FarmName Wright No. 2

TOPS	DEPTH	LOG	DATUM	Loc. in Sec.
Anh.				SE SE NE
TP.				
H.				
Tr.				
Dg.				
BL.				
L.				Geol. _____
K.C.				Contr. _____
B.K.C.				
Ce.				Wrico Tools
C.				
M.				Pool
M.				Graham
K.				
Mz.				
Me.				
V.				
S.				
S.				
A.				
R.				
PE.				
G.				
T.D.				

007 17 5  
 0  
 FIRST REPORT

Date Comm. spd 10-13-56  
1 1/4 8" @ 100 w/80, Drlg. 1290

OCT 27 1956

*209*

Sec.  
T.  
R.

County Cowley Elev. 1159  
 Sec. 10 Twp. 33 Rge. 3E  
 Company Crest Petroleum Co.  
 Farm Name Wright No. 2

TOPS	DEPTH	LOG	DATUM	Loc. in Sec.
Anh. <u>stall</u>	<u>2176</u>			SE SE NE
Tp. <u>lat</u>	<u>2582</u>			
H.				
Tr.				
Dg.				
BL.				
L.				Geol.
K.C.	<u>2752</u>			
B.K.C. <u>05W</u>	<u>2934</u>			Contr.
Ce. <u>SA</u>	<u>3054</u>			<u>Wrico Tools</u>
C. <u>SKIND</u>	<u>3137</u>			
M. <u>chat</u>	<u>3205</u>			Pool
M. <u>LI</u>	<u>3210</u>			<u>Graham</u>
K.	<u>3510</u>			
Mz.				
Ma.				
V.				
S.				
S.	<u>3584</u>			
A.				
R.				
PE.				
G.				
T.D.	<u>3737</u>			

NOV 28 '56  
 COMPLETE

Date Comm. spd 10-13-56  
spd 8" @ 100 w/80, Drlg. 1290  
3318 Oct. 31 '56 To be SWD  
well NOV 7 '56 5 1/2 3600 / 100 NOV 13 '56  
work NOV 21 '56 CO 3737 NOV 28 '56  
complete for SWD well.