


Map No. Kansas Sec. 15 Twp. 28 R. 13

Well No. 1 Johnson Farm
Taylor Lewis & Cook Company

NORTH

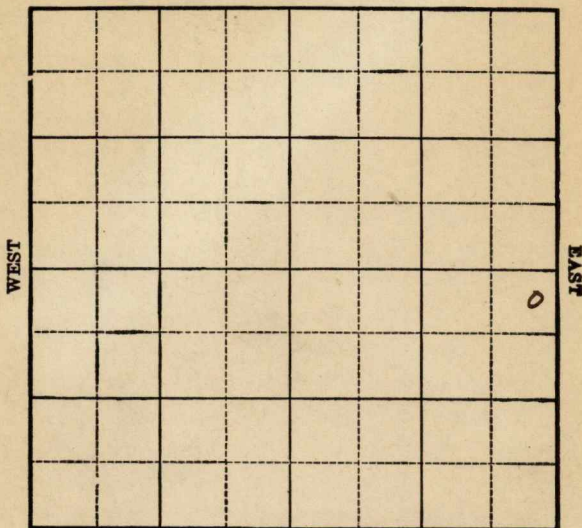

SOUTH

Location _____

Drilling Remarks:

RECORD

Cased _____ in. _____ ft.
 Sand _____
 Gas _____
 Oil _____
 Total Depth _____

Rig Up _____

Drilling Remarks:


PRODUCTION

1st 24 hrs. Nat. _____
 1st 24 hrs. after shot _____
 Gas _____ cu. ft.
 Dry Hole _____
 Abandoned _____

Map No. Kansas Sec. 15 Twp. 28 R. 13

Well No. 1 Johnson Farm
Taylor Lewis & Cook Company

200 Ft. from N. Line
Ft. from S. Line
200 Ft. from E. Line
Ft. from W. Line

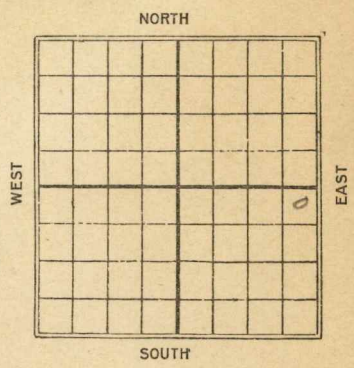

C.

Date	REPORT
1925	
3/24	Location
5/29	_____
6/5	_____
6/12	_____
6/19	_____
6/26	_____
7/3	_____
7/10	_____
7/17	_____
7/24	_____
7/31	Location also

Map No. **KANSAS** Sec. 15 Twp. 28 R. 13

Well No. 1 Jahuson

Jay Lov Lewis & Cook Company

Contractor

FIRST REPORT

200 Ft. from N. Line

----- Ft. from S. Line

200 Ft. from E. Line

----- Ft. from W. Line

SECTION PLAT

			0

Location ✓✓

Rig up -----

Drilling and Remarks:

RECORD

Cased ----- in., ----- ft.

Sand -----

Gas -----

Oil -----

Total Depth -----

PRODUCTION

1st 24 hrs. Nat. -----

1st 24 hrs. after shot -----

Gas ----- Cu. Ft.

Dry Hole -----

Abandoned -----

Date

3/24 5
----- 192 -----

M. A. BENEAR
----- Scout

Map No. Secs Sec. 15 Twp. 28 R. 13

Well No. 1 Johnson

Mytel-Lewis & Co. Inc Company

Contractor

COMPLETED

SECTION PLAT

200 Ft. from N. Line

_____ Ft. from S. Line

200 Ft. from E. Line

_____ Ft. from W. Line

			o

ABANDONED

Location _____

Rig up _____

Drilling and Remarks:

W.S. Location

RECORD

Cased _____ in., _____ ft.

Sand _____

Gas _____

Oil _____

Total Depth 10 1/2 100 1/2

PRODUCTION

1st 24 hrs. Nat. _____

1st 24 hrs. after shot _____

Gas _____ Cu. Ft.

Dry Hole _____

Abandoned Location

Date

JUL 31 1925

192

CHAS. L. SHERWOOD

Scout