


Map No. **KANSAS** Sec. 21 Twp. 28 R. 8
 Well No. 1 - Ferrell Farm
Burford & Bannan Company

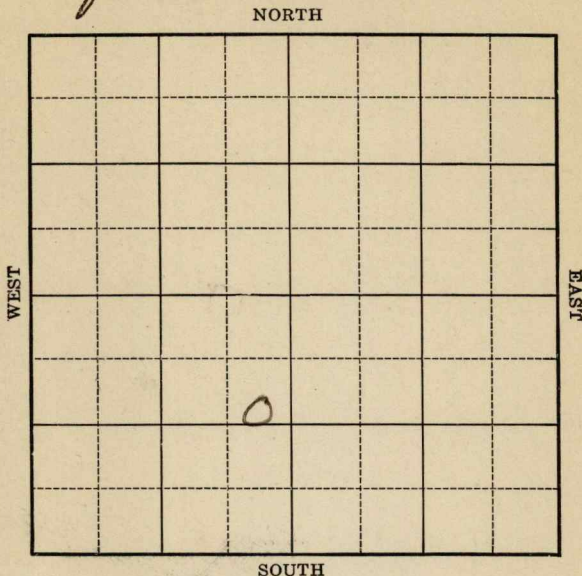

Location _____

Drilling Remarks _____

Rig Up _____

Drilling Remarks _____

RECORD

Cased _____ in. _____ ft.

Sand _____

Gas _____

Oil _____

Total Depth _____

PRODUCTION

1st 24 hrs. Nat. _____

1st 24 hrs. after shot _____

Gas _____ cu. ft.

Dry Hole _____

Abandoned _____

Map No. **KANSAS** Sec. 21 Twp. 28 R. 8Well No. 1-Ferrell Farm
Burford & Brim Company


NORTH

1020 Ft. from N. Line

_____ Ft. from S. Line

250 Ft. from E. Line

_____ Ft. from W. Line

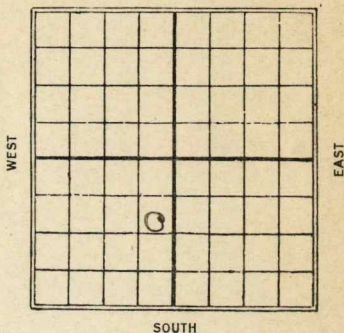1927

Date

REPORT

10/26 Location11/2 ——— 3/29 ———11/9 ——— 4/5 ———11/16 ——— 4/12 ———11/23 ——— 4/19 ———11/30 ——— 4/26 ———12/7 ——— 5/3 ———12/14 ——— 5/10 ———12/21 ——— 5/18 ———12/29 ——— 5/24 - a band Loc.19281/5 ———1/11 ———1/18 ———1/26 ———2/2 ———2/9 ———2/16 ———2/23 ———3/1 ———3/8 ———3/16 ———3/22 ———

10 KANSAS

Map No. _____ Sec. 21 Twp. 28 R. 8 E

Well No. 1

Ferrell
Burford & Grimm Company

Contractor

SECTION PLAT

1020 Ft. from N. Line

_____ Ft. from S. Line

250 Ft. from E. Line

_____ Ft. from W. Line

FIRST REPORTS

Location ✓ _____

Rig up _____

Drilling and Remarks:

RECORD

Cased _____ in., _____ ft.

Sand _____

Gas _____

Oil _____

Total Depth _____

PRODUCTION

1st 24 hrs. Nat. _____

1st 24 hrs. after shot _____

Gas _____ Cu. Ft.

Dry Hole _____

Abandoned _____

Date

OCT 26 1927

CHAS. L. SHERWOOD

192

Scout

MAP No. 10 **KANSAS** SEC. 21 TWP. 28 R. 8WELL No. 1 *Terrell**Burgard & Brimm* COMPANY

CONTRACTOR

COMPLETED**SECTION PLAT**1020 FT. FROM N. LINE FT. FROM S. LINE250 FT. FROM E. LINE FT. FROM W. LINE

ABANDONEDLOCATION RIG UP

DRILLING AND REMARKS:

RECORDCASED IN. FT.SAND GAS OIL TOTAL DEPTH **PRODUCTION**1ST 24 HRS. NAT. 1ST 24 HRS. AFTER SHOT GAS CU. FT.DRY HOLE ABANDONED DATE MAY 24 1928

192

SCOUT

CHAS. L. SHERWOOD*abd location**location*