


KANSAS

Map No. 2710 Sec. 27 Twp. 29 R. 9

Well No. 1 Harris Farm.

Mason & Phillips Company

NORTH

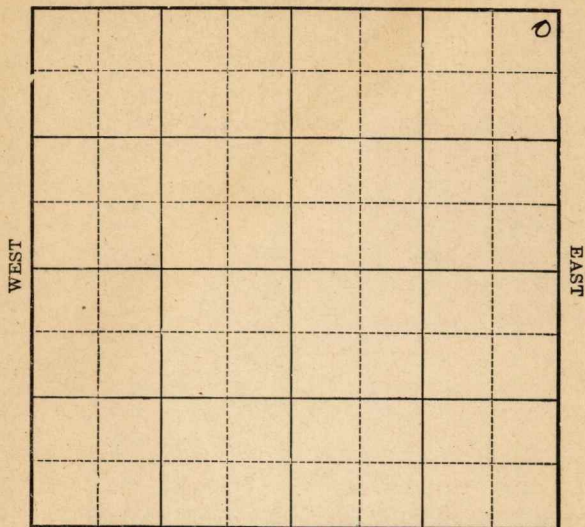

SOUTH

Location _____

Drilling Remarks:

Rig Up _____

Drilling Remarks:

RECORD

Cased _____ in. _____ ft.

Sand _____

Gas _____

Oil_____

Total Depth_____

PRODUCTION

1st 24 hrs. Nat._____

1st 24 hrs. after shot_____

Gas_____cu. ft.

Dry Hole _____

Abandoned _____

Map No. K Sec. 27 Twp. 29 R. 9

Well No. 1- Harris Farm


Matson & Phillips Company

200 Ft. from N. Line

_____ Ft. from S. Line

200 Ft. from E. Line

Ft. from W. Line

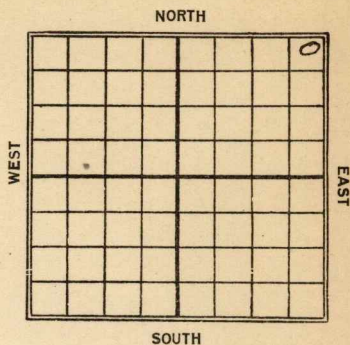

Date 1993

REPORT

11/3	relg 680'
7/16	LG + G 1520'

7/16 LB + G 1520'

Map No. **KANSAS** ¹⁰ Sec. 27 Twp. 29 R. 9Well No. 1 - HarrisMakson & Phillips Company

Contractor

FIRST REPORT**SECTION PLAT**200 Ft. from N. Line

_____ Ft. from S. Line

200 Ft. from E. Line

_____ Ft. from W. Line

			0

Location _____

Rig up _____

Drilling and Remarks:

Qty 680'**RECORD**

Cased _____ in., _____ ft.

Sand _____

Gas _____

Oil _____

Total Depth _____

PRODUCTION

1st 24 hrs. Nat. _____

1st 24 hrs. after shot _____

Gas _____ Cu. Ft.

Dry Hole _____

Abandoned _____

Date

NOV 3 1923

M. A. BENEAR

_____ 192____ Scout

Map No. ¹⁰ *Kans* Sec. *27* Twp. *29* R. *9*

Well No. *1* *Harris*
Malson & Phillips Company

Contractor

ABANDONED

SECTION PLAT

200 Ft. from N. Line

_____ Ft. from S. Line

200 Ft. from E. Line

_____ Ft. from W. Line

			<i>0</i>

Location _____

Rig up _____

Drilling and Remarks:

L & A
1520'

RECORD

Cased _____ in., _____ ft.

Sand _____

Gas _____

Oil _____

Total Depth _____

PRODUCTION

1st 24 hrs. Nat. _____

1st 24 hrs. after shot _____

Gas _____ Cu. Ft.

Dry Hole _____

Abandoned _____

Date

M.A.B.
192

7/23/24

Scout