

Barton


FORM 51

Section 5 Township 17 Range 13W

KANSAS

Well No. 1 - Cochrane

Company Derby Oil

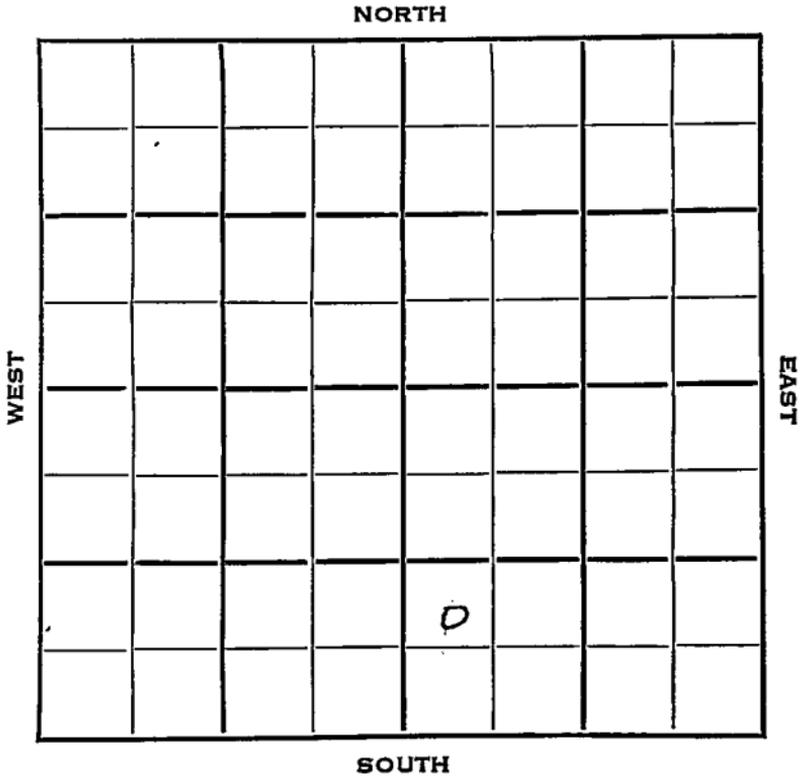

Sec. 5 Twp. 17 R. 13WWell No. #1 Cochrane Farm _____


Derby Oil _____ Company _____

Contractor _____

_____ Ft. from N. Line

990 Ft. from S. Line

_____ Ft. from E. Line

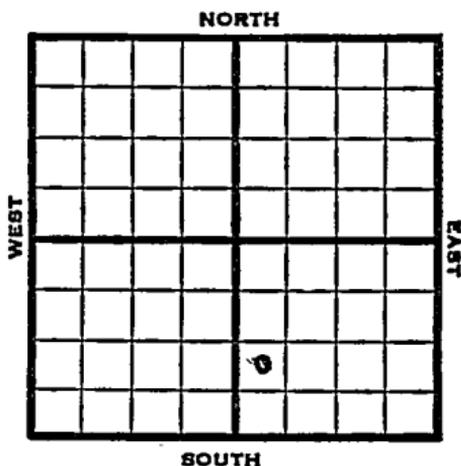330 Ft. from W. Line

NW SW SE

1953 Elev. 1903' REPORT

1/21 Location

1/29 8" @ 233'

2/5 Drlg. 2430'

2/12 Heeb 3056' Br li 3137' Lans 3146'
DST 3165-98, 1 hr, 15' M 970#
Drlg. 3364'2/19 Arb 3374
DST 3375-78, RTD 1 hr, 255' oil, 30'
wtr. 1150# 4" @ 3375 CO 3378
33 GOPH plus 2 GWPH 3 hrs.
10/3375-78 S/2 BFPH 8 hrs. little
water. 3000 A

2/26 S/7 BOPH 6 hrs.

3/11 Spud 1-26-53 Oil well TD 3378
8" @ 233 Heeb 3056 Br. line 3137
Lans 3146
DST 3165-98 open 1 hr. rec 15' mud
970# Arb. 3374
DST 3375-78 open 1 hr. rec 255' oil
30' wtr. 1150# 4" @ 3375 CO to
3378 33 GOPH 2 GW 10/3375-78
S/2 BFPH 8 hr. 300 A S/7 BOPH
6 hr.
Comp. 50 BOPD**COMPLETED**

County Barton State Kansas

Sec. 5 (Blk. Twp.) 17 (Sur. Rge.) 13W Map No.

Operator Derby Oil

Well No. 1 Farm Cochrane

Elev. _____ Location NE SW SE

FIRST REPORT

990 Ft. From S Line SE

330 Ft. From W Line Quarter

Ist. Report JAN 21 1952

Completion _____

Remarks _____

Spudding Date _____

Drlg. Data _____

Location


County Barton State Kansas

Sec. 5 (Blk. 17) (Sur. Rge.) 13W Map No.

Operator Derby Oil

Well No. 1 Farm Cochrane

Elev. 1903 Location NW SW SE

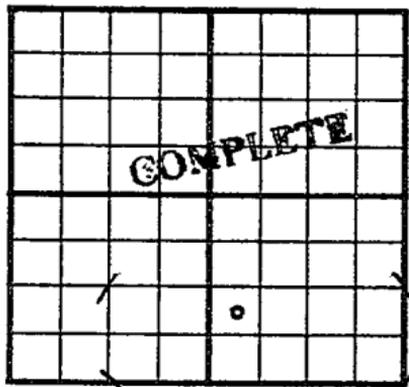

990 Ft. From S Line SE

330 Ft. From W Line Quarter

1st. Report

Completion MAR 11 1953

Remarks

Spudding Date 1-26-53

Drig. Data Oil well TD 3378

8" @ 233 Heeb. 3056 Br. lime 3137

Lans. 3146 DST 3165-98 open 1 hr.

Rec. 15' mud 970# Arb. 3374

DST 3375-78 open 1 hr. Rec. 255' oil

30' wtr. 1150# 4" @ 3375 CO to 3378

33 goph 2 gw 10/ 3375-78 S/ 2 bfph

8 hr. 300 A S/ 7 boph 6 hr.

Comp. 50 bopd