


Section 5 Township 17 Range 13 W

Well No. # 1 Ford

Company Duke & Wood

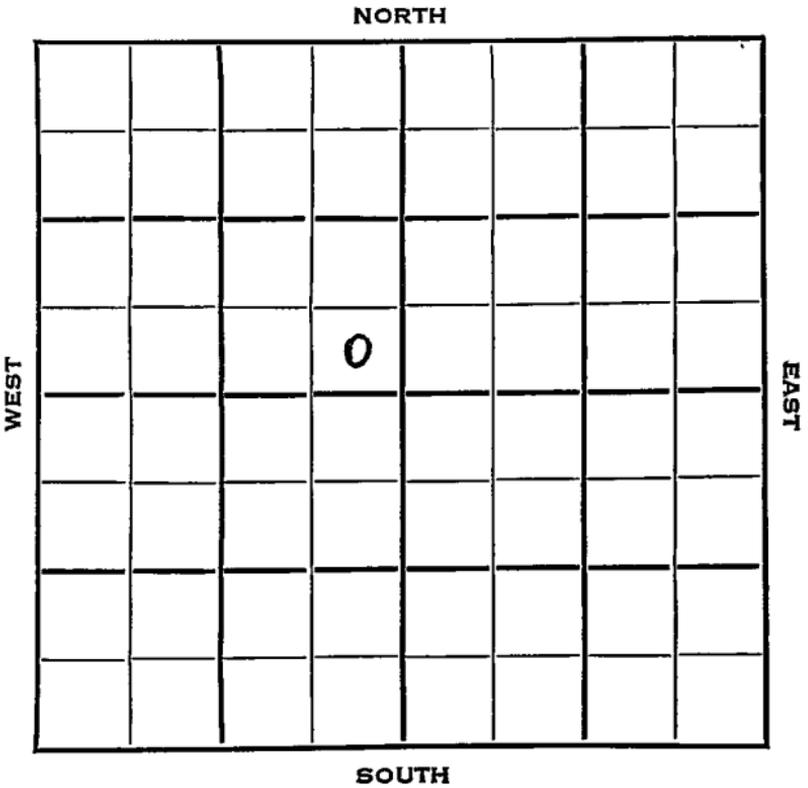

Sec. 5 Twp. 17 R. 13W

Well No. #1 Ford Farm

Duke & Wood Company

Duke & Wood Contractor


\_\_\_\_\_ Ft. from N. Line

330 Ft. from S. Line

330 Ft. from E. Line

\_\_\_\_\_ Ft. from W. Line

SE SE NW

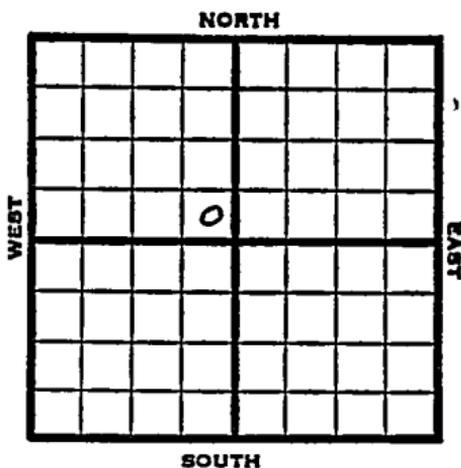

1953

Elev. 1918' REPORT

6/24

Spud 6-13-53

8" @ 260'

Drlg 3340'

7/1

Spud 6-13-53 D & A

TD 3400 8" @ 260 Anhy 862

Heeb 3065 Br. lime 3147 Lans 3154

Arb. 3379

DST 3379-83 open 25 min rec 9' mud

DST 3381-91 open 35 min rec 10' mud

VSSO 580# TD 3400

D & A

**ABANDONED**


County Barton State KANSAS

Sec. 5 (Blk. Twp.) 17 (Sur. Rge.) 13W Map No.

Operator Duke & Wood

Well No. 1 Farm Ford

Elev. \_\_\_\_\_ Location SE SE NW

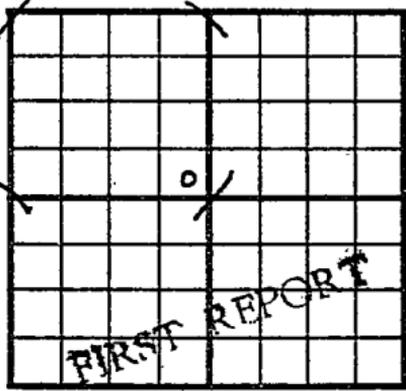

330 Ft. From S Line NW

330 Ft. From E Line Quarter

Ist. Report JUN 24 1953

Completion \_\_\_\_\_


Remarks \_\_\_\_\_

Duke & Wood - Contr.

Spudding Date 6-13-53

Drlg. Data \_\_\_\_\_

8" @ 260 drlg. 3340

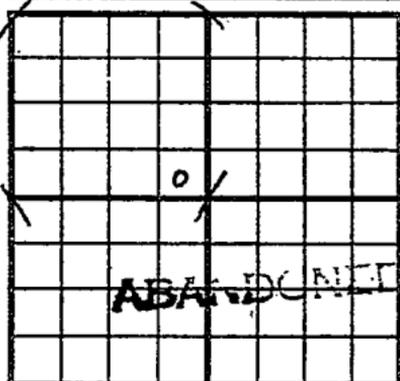County Barton State KansasSec. 5 (Blk.  
Twp.) 17 (Sur.  
Rge.) 13W Map No.Operator Duke & WoodWell No. 1 Farm FordElev. 1918 Location SE SE NW330 Ft. From S Line NW330 Ft. From E Line Quarter

1st. Report

Completion JUL 1 1953

Remarks

Duke & Wood - Contr.Spudding Date 6-13-53Drig. Data D & A TD 34008" @ 260 Anhy 862 Heeb. 3065Br. lime 3147 Lans. 3154 Arb. 3379DST 3379-83 open 25 min. Rec. 9' mudDST 3381-91 open 35 min. Rec. 10' mudVSSO 580# TD 3400D & A