

Sec. 6 Twp. 17 R. 13W

Well No. #2 Putnam Farm

Derby Drlg. Company

Rocket - Contr. Contractor


_____ Ft. from N. Line

990' Ft. from S. Line

_____ Ft. from E. Line

990' Ft. from W. Line

NE SW SW

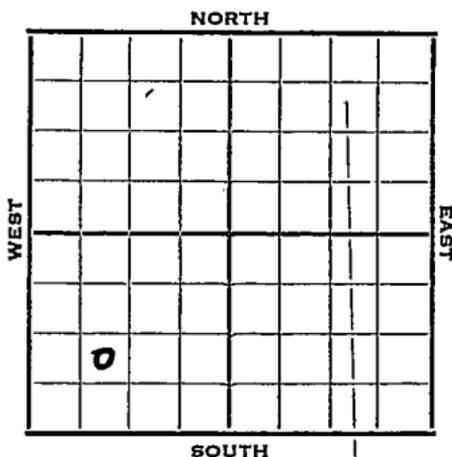

1952

Elev. 1973' REPORT

8/27

Pits

9/3

"

9/10

10" @ 254' Anhy 933'
Drlg. 2300'

9/17

Spud 9-5-52
D&A TD 3475'
10" @ 254 Anhy 933 Heeb. 3136
Br Li 3213 Lans. 3221
DST 3263-94 open 3/4 hr. rec.
5' mud Off Cong. 3442 * ReArb.
3452 Arb. 3457
TD 3475' D&A

ABANDONED

