


Section 7 Township 17 Range 13W

Well No. #1 Persons

Company D.T. Ingling

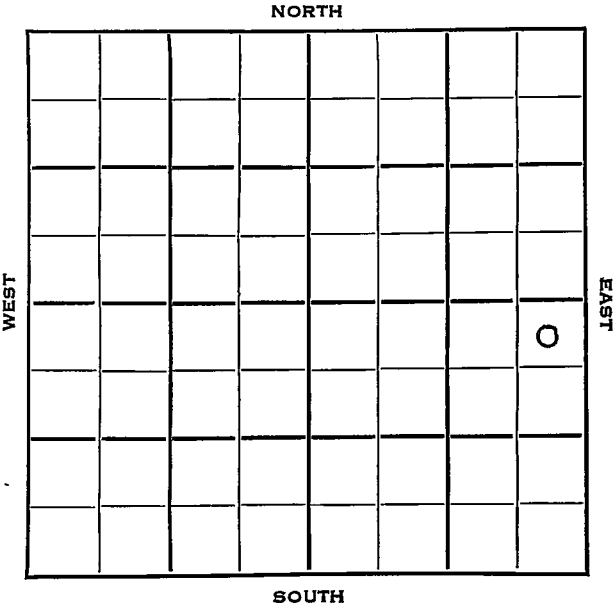

Barton

KANSAS ✓

Sec. 7 Twp. 17 R. 13W

Well No. #1 Persons 1 Farm

D.T. Ingling Company

Ingling. Contractor

Wildcat.


330 Ft. from N. Line

 Ft. from S. Line

330 Ft. from E. Line

 Ft. from W. Line

NE NE SE

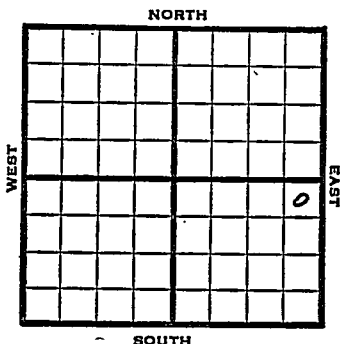

1953 Elev. 1971' REPORT

4/29 R U R
5/7 8" @ 280'
Dr1g 2336'
5/20 Spud 4-27-53
D&A
TD 3495
8" @ 280
Top 2902, Heeb 3141, Tor 3157, Br lime
3221, Lans 3230
DST 3257-3300, opn 20 mins., rec.
20' mud, 1060#
DST 3371-81, opn 25 mins., rec. 35'
mud, 65#
Cong 3453, ReArb 3462, Arb. 3467
~~TD~~ TD 3495
D&A

ABANDONED

County **Barton** State **Kansas**

Sec. 7 (Blk. 17 (Sur. 13W Map No.

Operator D. T. Ingling

Well No. **1** Farm **Persons**

Elev.	Location	NE	NE	SE
-------	----------	----	----	----

FIRST REPORT

330 Ft. From N Line SE

330 Ft. From E Line Quarter

1st. Report APR 29 1953

Completion

Remarks


Ingling - Contr.

Spudding Date

Drig. Data Wildcat

RUR

County Barton State Kansas
 Sec. 7 (Blk.) 17 (Sur.) 13W Map No.
 Operator D. T. Ingling
 Well No. 1 Farm Persons
 Elev. 1971 Location NE NE SE

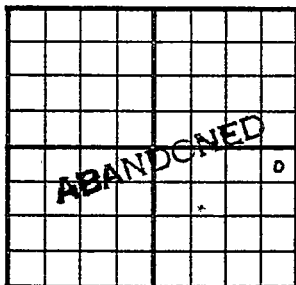

330 Ft. From N Line SE
330 Ft. From E Line Quarter

1st. Report

Completion MAY 20 1953

Remarks Wildcat

Ingling - Contr.

Spudding Date 4-27-53

Drig. Data D & A TD 3495

8" @ 280 Top. 2902 Heeb. 3141

Tor. 3157 Br. lime 3221 Lans. 3230

DST 3257-3300 open 20 min. Rec. 20' mud

1060# DST 3371-81 open 25 min.

Rec. 35' mud 65# Cong. 3453

ReArb. 3462 Arb. 3467 TD 3495

D & A

J. G. McGEHEE