


# KANSAS

Section 11 Township 13 Range 17W

Well No. #1 Anderson "C"

Company Cities Service

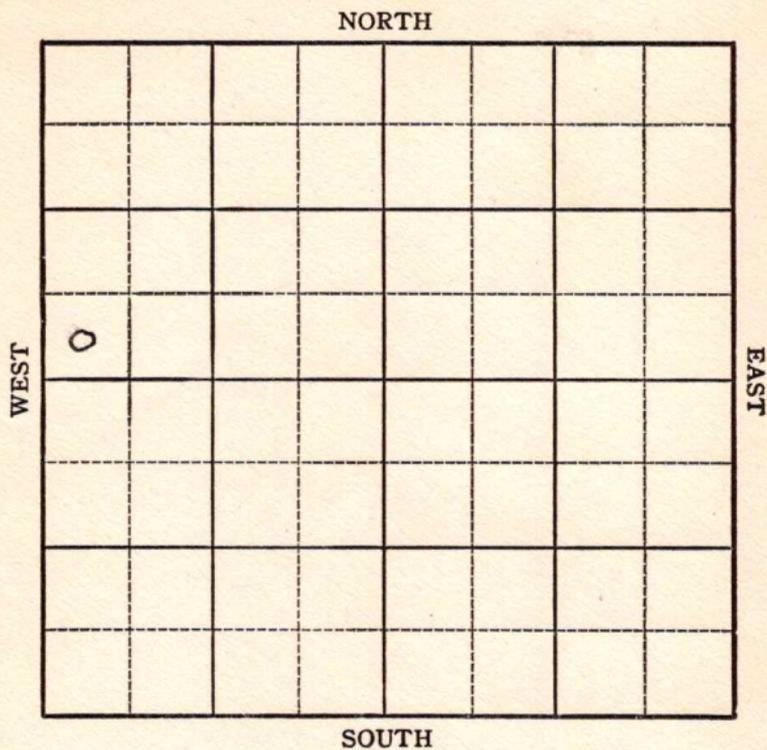

Sec. 11 Twp. 13 R. 17W

Well No. #1 Anderson "C" Farm

Cities Service

Company

Catherine Pool


\_\_\_\_\_ Ft. from N. Line

330' Ft. from S. Line

\_\_\_\_\_ Ft. from E. Line

330' Ft. from W. Line

SW NW

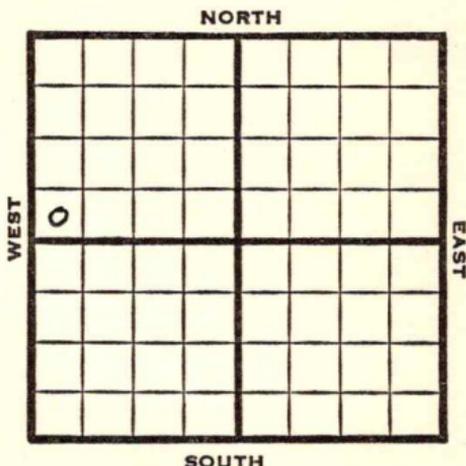

1949

Elev 2016'

REPORT

8/17	Location
8/24	8" @ 1210' Drlg. 1660'
8/31	Drlg. 3455'
9/7	Lansing 3269' Arbuckle 3526' TD 3528' 5" @ 3528'
9/14	TD 3538 500 acid Swb 15 bbls oil PH 3 hrs.
9/21	1000 acid Pump 133 bbls oil 7 hrs. TD 3544'
9/28	"
10/5	"
10/12	"
10/19	"
10/26	"
11/1	"
11/9	"
11/16	TD 3544' Arb. 3526' 5"@ 3528' 1000 acid Pump 367 Oil Pot 27° Gr. Comp

COMPLETED

Map No. \_\_\_\_\_ Sec. 11 Twp. 13 R. 17W

Well No. 1 Anderson "C"

Cities Service Company

Contractor

SW NW

FIRST REPORT  
SECTION PLAT

\_\_\_\_\_ Ft. from N. Line

330 Ft. from S. Line

\_\_\_\_\_ Ft. from E. Line

330 Ft. from W. Line


Ellis County

Location x

Rig up \_\_\_\_\_

Drilling and Remarks:

RECORD

Cased \_\_\_\_\_ in., \_\_\_\_\_ ft.

Sand \_\_\_\_\_

Gas \_\_\_\_\_

Oil \_\_\_\_\_

Total Depth \_\_\_\_\_

PRODUCTION

1st 24 hrs. Nat. \_\_\_\_\_

1st 24 hrs. after shot \_\_\_\_\_

Gas \_\_\_\_\_ Cu. Ft.

Dry Hole \_\_\_\_\_

Abandoned \_\_\_\_\_

Date

AUG 17 1949 19

S. L. LEWIS Scout

Kansas

Map No. \_\_\_\_\_ Sec. 11 Twp. 13 R. 17W

Well No. 1 Anderson "C"

Cities Service

Company

COMPLETE

Contractor

SW NW

*E. 2016*

SECTION PLAT

\_\_\_\_\_ Ft. from N. Line

330 Ft. from S. Line

\_\_\_\_\_ Ft. from E. Line

330 Ft. from W. Line


Ellis County

Location \_\_\_\_\_

Rig up \_\_\_\_\_

Drilling and Remarks:

*Art 3526*  
*5" @ 3525*  
*1000 acid*  
*Pump 367 oil 27*  
*27 2/3*

RECORD

Cased \_\_\_\_\_ in., \_\_\_\_\_ ft.

Sand \_\_\_\_\_

Gas \_\_\_\_\_

Oil \_\_\_\_\_

Total Depth 3044

PRODUCTION

1st 24 hrs. Nat. \_\_\_\_\_

1st 24 hrs. after shot \_\_\_\_\_

Gas \_\_\_\_\_ Cu. Ft.

Dry Hole \_\_\_\_\_

Abandoned \_\_\_\_\_

Date

NOV 16 1949

19

S. J. LEWIS

Scout

O. W. P. B.

FORM 513 SUNRAY

County Ellis Elev. 2016 DF

Sec. 11 Twp. 13 Rgs. 17W

Company C. S. O.

Farm Name Anderson "C" No. 1

TOPS DEPTH LOG DATUM

Anh.			
Tp.			
H.			
Tr.			
Dg.			
Bl.			
L.		3273	
K.C.			
B.K.C.			
Ce.			
C.			
M.			
M.			
K.			
Mz.			
Me.			
V.			
S.			
S.			
A		3530	
R.			
Pe.			
G.			
T.D.	<u>OTD</u>	<u>3544</u>	

Loc. in Sec.

SW SW NW

(O.W.P.B.)

Geol.

Contr.

Pool

Catherine

FIRST REPORT

COMPLETE

AUG 28 '87

Date Comm. Old Info. - 5" @ 3532, Arb well

New Info. - P. B. 3508, 164/3295-3459

2500A, Phy Pot 205 BO + 22% wtr/24 hrs

COMPLETE

~~14~~

Co.

Sec.

No.

Sec.

T.

R.