


Section 7 Township 17 Range 13W

Well No. #1 Putman

Company Rocket Drlg.

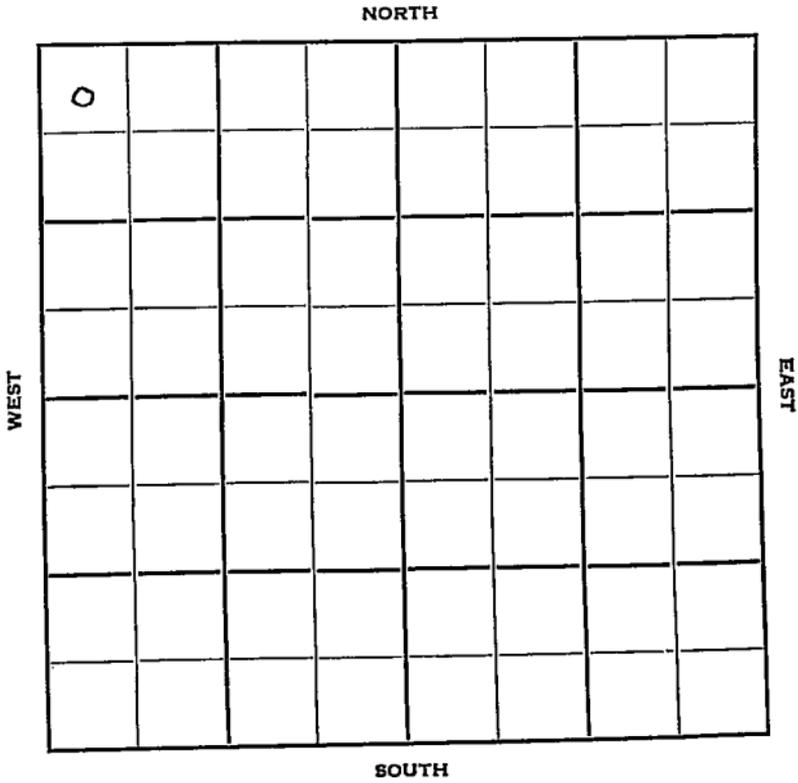

Sec. 7 Twp. 17 R. 13W

Well No. #1 Putman Farm

Rocket Drlg. Company

Rocket Drlg. - Contr. Contractor

Wildcat


330' Ft. from N. Line

_____ Ft. from S. Line

_____ Ft. from E. Line

330' Ft. from W. Line

NW NW NW

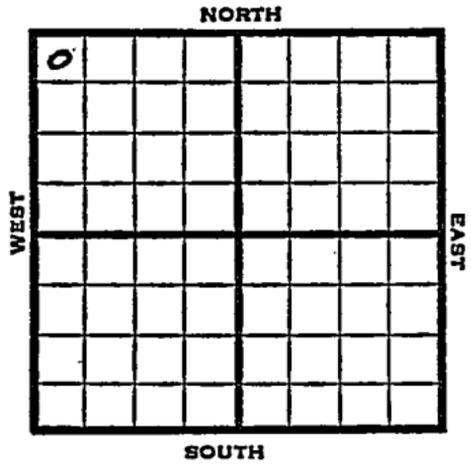

1951 Elev. 1982 REPORT

9/19 Spud 9-15-51
8" @ 255'

11/28 Spud 9-15-51
Oil Well TD 3489
8" @ 255
Heeb. 3141 Br Lime 3215
Lans. 3224 SSO 3225-29
DST 3219-34 opn 1 hr
Rec. 25' mud
DST 3247-97 opn 1 hr
Rec. 420' hocm
BKC 3435 Cong. 3440
Arb. 3454-56
5 " @ 3455
TD 3489 HFW PB 3412
24/3286-93 S/2 1/4 boph 1000 A
P/7 boph Comp. 212 bopd 4% wtr.

COMPLETED

County **Barton** State **Kansas**

Sec. **7** (Blk. Twp.) **17** (Sur. Rge.) **13W** Map No.

Operator **Rocket Drig.**

Well No. **1** Farm **Putman**

Elev. Location **NW NW NW**

0							

330 Ft. From **N** Line **NW**

330 Ft. From **W** Line **Quarter**

Ist. Report **SEP 19 1951**

Completion

Remarks

Rocket Drig. - Contr.

Spudding Date **9-15-51**

Drig. Data **Wildcat**

8" @ 255

County **Barton** State **Kansas**

Sec. **7** (Blk. Twp.) **17** (Sur. Rge.) **13W** Map No.

Operator **Rocket Drlg.**

Well No. **1** Farm **Putman**

Elev. **1982** Location **NW NWNW**

0						

COMPLETE

330 Ft. From N Line NW

330 Ft. From W Line Quarter

Ist. Report

Completion **NOV 28 1951**

Remarks **Wildcat**

Rocket Drlg. - Contr.

Spudding Date **9-15-51**

Drlg. Data **Oil well TD 3489**

8" @ 255 Heeb. 3141 Br. lime 3215

Lans. 3224 SSO 3225-29 DST 3219-34

open 1 hr. Rec. 25' mud DST 3247-97

open 1 hr. Rec. 420' hocom B KC 3435

Cong. 3440 Arb. 3454-56 5" @ 3455

TD 3489 HFW PB 3412 24/ 3286-93

S/ 2 1/4 boph 1000 A P/ 7 boph

Comp. 212 bopd 4% water