

Sec. 20 Twp. 29S Range 17E

1 Altoona

Kansas Geological Society
Sunray Mid-Continent
Skelly Scout Tickets

HOT FILE

Wilson

KANSAS

SEC. TWP. R.

20

29 S

17 E

WELL NO. (Altoona Water flood)

1 Altoona

FARM

COMPANY

Sunray Mid-Continent (DEVELOPMENT)

CONTRACTOR


Mesker Drlg.
Altoona Field.

_____ FT. FROM N. LINE

990 _____ FT. FROM S. LINE

990 _____ FT. FROM E. LINE

of SW/4 _____ FT. FROM W. LINE

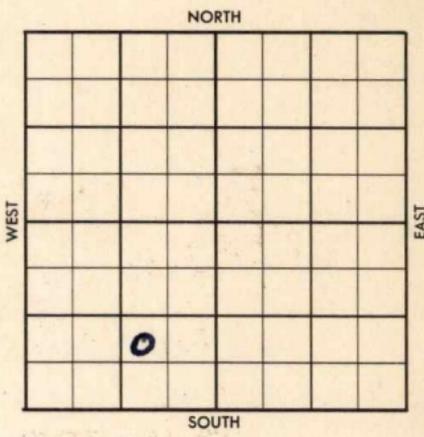

NW SE SW

	ELEVATION	REPORT
1956		

9/28	MIRT	<p>1050' Bartlesville Test <i>No FR</i> (DR#190)</p>
10/1	Spudded 9-28-56	
	TD 834'. Prep to core.	
10/2	TD 914'. Prep to run csg.	
10/3	TD 914'. Temporarily Abandoned(DR#193)	

ABANDONED