

KANSAS


Barton

Section 9 Township 17 Range 13W

Well No. 1 Rathbun

Company Petroleum Inc. (was Phil-Han)
Phillips & Hansen

Wildcat

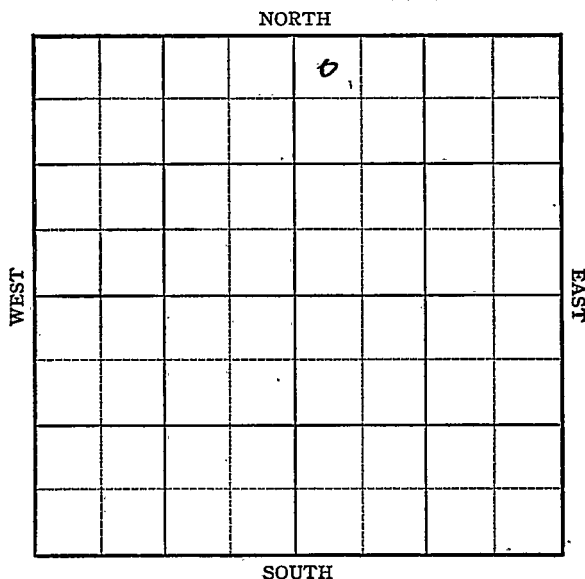

O. W. D. D.
KANSAS

Barton

Sec. 9 Twp. 17 R. 13W ☒

Well No. #2 #1 Rathbun Farm
Petroleum, Inc. (was Phil-Han)
Phillips & Hansen Company


Wildcat (Phillips & Hansen, Cont.) ^{GARY, OIL} NORTH

330' Ft. from N. Line

Ft. from S. Line

Ft. from E. Line

330' Ft. from W. Line

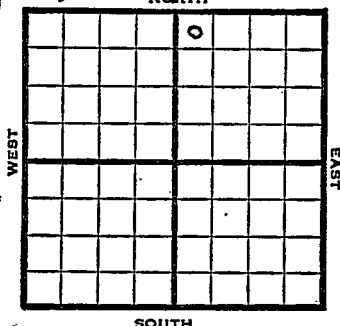

NW NE

SOUTH

1949 Elev 1893' REPORT

5/18 Location
5/25 8" @ 255'
Lansing 3117'
Drlg 3299'
6/1 TD 3362'
Arb. 3357'
Aband.

ABANDONED

1951 **O. W. D. D.**
5/23 Arb. 3357'
5" @ 3359' OTD 3363' DD 3363'
WOCT
7/25 Oil well TD 3363'
Arb. 3357' 5" @ 3359' OTD 3362'
DD 3363' S/165 BOPD
DST 3343-63 open 1 hr. rec 430' gassy
oil
Comp. 160 BOPD

COMPLETED

Map No. _____ Sec. 9 Twp. 17 R. 13WWell No. 1 Rathbun

_____ Phillips & Hansen _____ Company


_____ Phillips & Hansen _____ Contractor

NW NE

FIRST REPORT
SECTION PLAT330 Ft. from N. Line

_____ Ft. from S. Line

_____ Ft. from E. Line

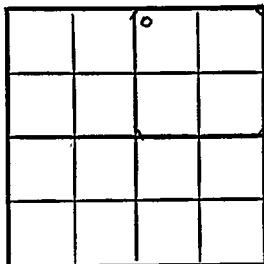330 Ft. from W. LineBarton CountyLocation X

Rig up _____

Drilling and Remarks:

RECORD

Cased _____ in., _____ ft.

Sand _____

Gas _____

Oil _____

Total Depth _____

PRODUCTION

1st 24 hrs. Nat. _____

1st 24 hrs. after shot _____

Gas _____ Cu. Ft.

Dry Hole _____

Abandoned _____

Date

MAY 18 194919S. J. LEWISScout

Wildcat

Kansas

Map No. K 73 Sec. 9 Twp. 17 R. 13WWell No. 1 RathbunPhillips & Hansen

Company

ABANDONED

Contractor

NW NE

E 11893
SECTION PLAT330 Ft. from N. Line Ft. from S. Line Ft. from E. Line330 Ft. from W. Line

		0	

Barton County

Location Rig up

Drilling and Remarks:

Cr & 3357

RECORD

Cased in., ft.Sand Gas Oil Total Depth 2362

PRODUCTION

1st 24 hrs. Nat. 1st 24 hrs. after shot Gas Cu. Ft. Dry Hole Abandoned

Date

JUN 1 1949 19S. J. LEWIS

Scout

County Barton State Kansas
 Sec. 9 (Blk.) 17 (Sur.) 13W Map No.
 Operator Petroleum Inc. (was Phil-Han)
 Well No. 1 Farm Rathbun
 Elev. 1893 Location NW NW NE

330 Ft. From N Line NE330 Ft. From W Line Quarter1st. Report MAY 23 1951Completion O. W. D. DRemarks OWDDGarvey Oil - Contr.

Spudding Date

Drlg. Data

Arb. 3357 5" @ 3359 OTD 3363 DD 3363WOCT

J. E. TYRA

County Barton State KansasSec. 9 (Blk.) 17 (Sur.) 13W Map No.Operator Petroleum Inc.Well No. 21 Farm RathbunElev. 1893 Location NW NW NE

330 Ft. From N Line NE330 Ft. From W Line Quarter

1st. Report

Completion JUL 25 1951Remarks OWDDGarvey Oil - Contr.

Spudding Date

Drlg. Data Oil well TD 3363Arb. 3357 5" @ 3359 OTD 3362 DD 3363S/ 165 bopd DST 3343-63 open 1 hr.Rec. 430' gassy oil Comp. 160 bopd

J. E. TYRA