
Sumner KANSAS

SECTION 6 TOWNSHIP 30 RANGE 1E

WELL NO. #1 Rambo

COMPANY Brunson Drlg.

NORTH SW SW SE

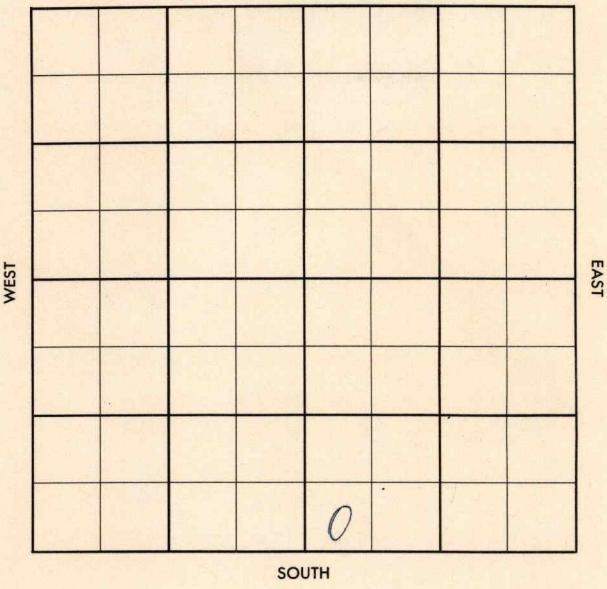

FORM 504-3 SUNRAY

WILDCAT

FORM 513 SUNRAY

County Sumner Elev.

Sec. 6 Twp. 30 Rge. 1E

Company Brunson Drlg.

Farm Name Rambo No. 1

TOPS	DEPTH	LOG	DATUM
Anh.			
T.P.			
H.			
Tr.			
Dg.			
B.L.			
L.			
K.C.			
B.K.C.			
Ce.			
C.			
M.			
M.			
K.			
Mz.			
Mo.			
V.			
S.			
S.			
A			
R.			
P€.			
G.			
T.D.			

Loc. in Sec. SW SW SE

Geol.

Contr. Co. tools

Pool Wildcat

FIRST REPORT

MAY 1 1957

0

Date Comm.

M I R

Co. Lse. No. Sec. T. R.

FORM 513 SUNRAY

County Sumner Elev. 1257

Sec. 6 Twp. 30 Rge. 1W

Company Brunson Mfg. Co.

Farm Name Rambo No. 1

TOPS	DEPTH	LOG	DATUM
Anh. Stan	2618		
Tp.			
H.			
Tr.			
Dg.			
B.L.			
L.			
K.C.	2801		
B.K.C. Marm	3030		
Ce.	3298		
C.			
M.	3407		
M.			
K.	3783		
Mz.			
Mo.			
V.			
S.	3844		
~~B.~~ Base	3850		
A			
R.			
P€.			
G.			
T.D.	3875		

Loc. in Sec. SW SW SW

Geol.

Contr. Co. tools

Pool Wildcat

JUN 5 '57

ABANDONED

Date Comm.

M T P MAY 8 57 5-1-57 D 0 252

MAY 15 57 8 5/8 314 / D 2500 MAY 22 57

Crg @ 3850 MAY 29 57 JUN 5 57 DST 3844

-50 1hr 20' Mud BHP 80/20#

D & A (~~D & A~~)

Co. Lse. No. Sec. T. R.