


Section 7 Township 30 Range 1-E

Well Number 1 - Blair


Company Wm. McKnabb

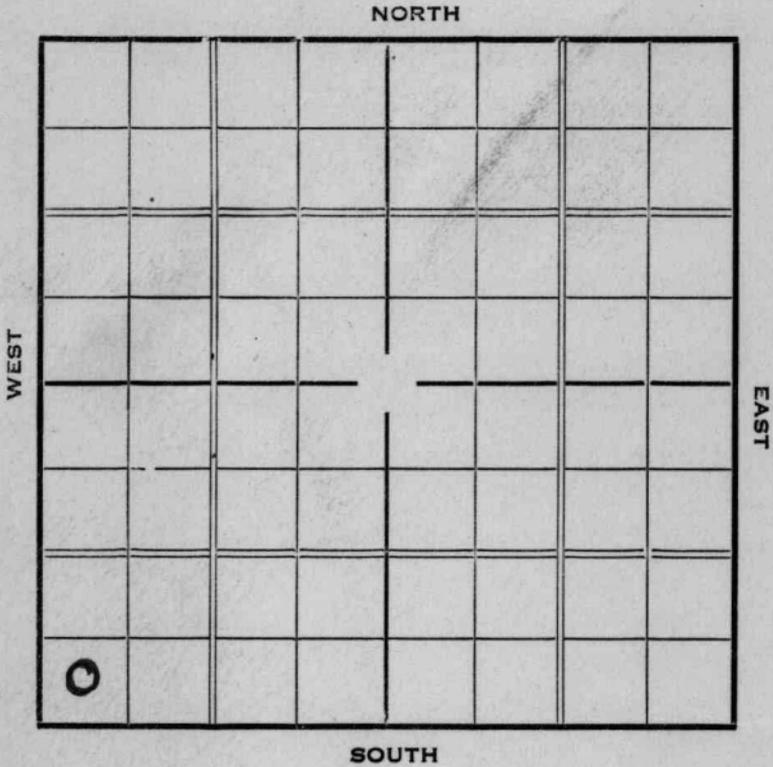

Sec. 7 Twp. 30 R. 1-E

Well No. #1 Blair Farm
Wm. McKnabb Company

 Ft. from N. Line
330 Ft. from S. Line
 Ft. from E. Line
330 Ft. from W. Line
 Elev. 1244

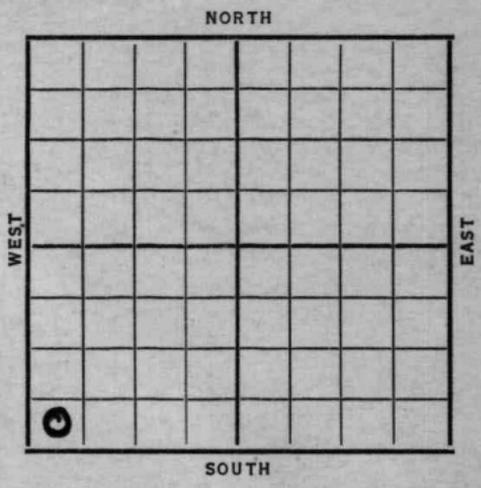

Date	REPORT
1937	
5/19	Location
5/28	B. R.
6/4	"
6/11	"
6/19	"
6/25	"
7/2	"
7/9	"
7/16	FSG. 200'.
7/23	15" @ 244'. T.D. 850'. C.O.
7/30	12" @ 1110' T.D. C.O.
8/6	T.D. 1387' U. R. 12".
8/13	" " " "
8/20	" " " "
8/28	" " " "
9/3	" " " "
9/10	" " " "
9/17	10" @ 2700'. Drlg. 3100'.
9/24	Drlg. 3153'.
10/2	Drlg. 3300'.

OVER

1937

10/8 Drlg. 3300'.

10/16 Top Wilcox 3866 6" 3810 TD 3869
2500 feet oil hole 42 Gravity
Building tanks (Tel)

10/15--8" 3150 Chat. 3386 Miss. 3423
S.O. & 1/4 BW at 3800-10
Wilcox 3866-67 TD 500' Oil in 8 hrs.
Est. 42 Gravity Rng 6" (Dlg. report)

10/16--Top Wilcox 3866 6" 3810 TD 3869
2500 feet oil hole 42 Gravity
Building tanks (Tel)

10/18--Had 3000 feet oil in hole
Swabbed into ponds for 2½ hours
Lowered oil to 1400 feet Swabbed into
ponds for 3 more hours Did not ~~lower~~
lower Unable to get much information
on this well No estimate size of
well (Tel)

10/20--Correction--T.D. 3867
Gravity oil 45.9 corrected
Shut in (Tel)

10/27--Drilled to T.D. 3869
Shot 10 qts. Cleaning out (Tel)

11/5 Shut down.

11/12 " "

11/19 " "

11/26 " "

12/3 " "

12/10 " "

12/17 " "

12/24 " "

12/31 " "

OVER

1938

1/7 TD 3869' SD.

1/14 " "

1/20--Flowing potential 386 bbls. in 8 hrs.
Two, four hour gauges of which we have
no record. (Tel)

1/19 6" @ 3810'.

Wilcox 3866'.

T.D. 3869'.

Shot 10 qts.

Potential 386 bbls., Flowing.

COMPLETED

Map No. 12 Sec. 7 Twp. 30 R. 1E

Well No. 1-Blair

McKnabb

Company

Contractor

COMPLETED

SW/c

SECTION PLAT

_____ Ft. from N. Line

330 Ft. from S. Line

_____ Ft. from E. Line

330 Ft. from W. Line

0			

Location _____

Rig up _____

Drilling and Remarks:

*Shot 10 gts
Pot 386
Flowing*

RECORD

Cased 6 in., 3810 ft.

Sand Wilcox 3866

Gas _____

Oil _____

Total Depth 3869

PRODUCTION

1st 24 hrs. Nat. _____

1st 24 hrs. after shot _____

Gas _____ Cu. Ft.

Dry Hole _____

Abandoned _____

Date

JAN 19 1938 19

H. D. Hatfield Scout

KANSAS *Summer*

Map No. 12 Sec. 7 Twp. 30 R. 1E

Well No. 1-Blair

Wm McKnabb Company

Contractor

FIRST REPORT

SECTION PLAT

_____ Ft. from N. Line

330 Ft. from S. Line

_____ Ft. from E. Line

330 Ft. from W. Line

0			

Location ✓

Rig up _____

Drilling and Remarks:

RECORD

Cased _____ in., _____ ft.

Sand _____

Gas _____

Oil _____

Total Depth _____

PRODUCTION

1st 24 hrs. Nat. _____

1st 24 hrs. after shot _____

Gas _____ Cu. Ft.

Dry Hole _____

Abandoned _____

Date

MAY 19 1937₁₉

H. D. Hatfield Scout