Form 51—5M—7-25—19786

Map No. Kansas Sec. 17 Twp. 12 R. 15W.

Well No. 2 - Munsell Farm

Various Oil Company

NORTH

WEST

EAST

SOUTH

Location	Rig Up
Drilling Remarks	Drilling Remarks
RECORD	PRODUCTION
Cased in. ft.	1st 24 hrs. Nat.
Sand	1st 24 hrs. after shot
Gas	Gas cu. ft.
Oil	Dry Hole
Total Depth	Abandoned

Form 252A—5M—7-25—19684

Russell

Map No. Kansas Sec. 17 Twp. 12 R 15W

Well No. 2 Munsell Farm


Valerious O. & G. Company

330 Ft. from N. Line

Ft. from S. Line

Ft. from E. Line

990 Ft. from W. Line

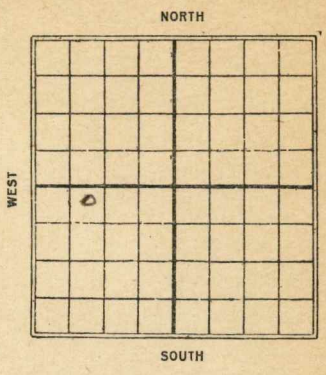

Date 1926	REPORT
4/7	R.O.G.
4/14	Rig and tools
4/21	Spud.
4/29	Dlg 540'
5/5	" 932
5/12	" 1674'
5/19	" 2700
5/26	" 2615'
6/2	2615' Cementing.
6/9	Drlg. 2800'
6/23	Sand 3017-3027 120 bbls

Form 26 NMBRs 3-23-11959.

No map


Map No. KANSAS Sec. 17 Twp. 12 R. 15 W

Well No. 2 Munsell

Kaleidas O & G Company

Contractor

SECTION PLAT

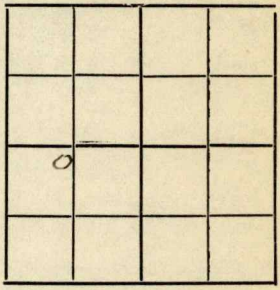

330 Ft. from N. Line

Ft. from S. Line

Ft. from E. Line

990 Ft. from W. Line

FIRST REPORTS

Location

Rig up

Drilling and Remarks:

R C G.

RECORD

Cased in., ft.

Sand

Gas

Oil

Total Depth

PRODUCTION

1st 24 hrs. Nat.

1st 24 hrs. after shot

Gas Cu. Ft.

Dry Hole

Abandoned

Date

APR 7 1926

S. J. LEWIS Scout

Form 26–1M Bks.–3-23–11959.

Russell


Map No._____ Sec. 17 Twp. 12 R. 15 W

Well No. 2 Mansell C

Valerius O & G. Company

_____ Contractor

SECTION PLAT

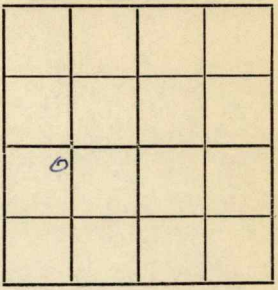

330 Ft. from N. Line

_____ Ft. from S. Line

_____ Ft. from E. Line

990 Ft. from W. Line

COMPLETED

Location _____

Rig up _____

Drilling and Remarks:

Sand

3017 to 3027

1208 to.

RECORD

Cased _____ in., _____ ft.

Sand _____

Gas _____

Oil _____

Total Depth _____

PRODUCTION

1st 24 hrs. Nat. _____

1st 24 hrs. after shot _____

Gas _____ Cu. Ft.

Dry Hole _____

Abandoned _____

Date

JUN 23 1926

_____ 192___. S. J. LEWIS Scout