DX 78-1


Sumne

KANSAS

Section 3 Township 30 Range 1E

Well No. #1 Orrell

Company White & Ellis & Pack Oil Co.

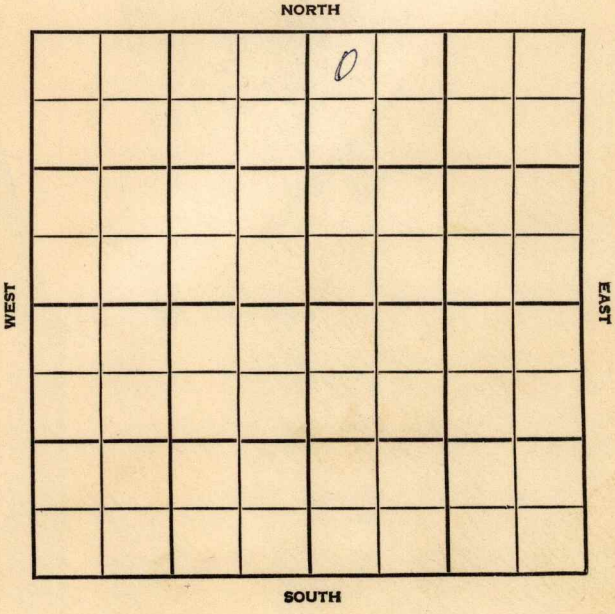

FORM 513 SUNRAY

County Sumner Elev. 1232

Sec. 3 Twp. 30 Rge. 1E

Company White & Ellis & Pack Oil Co.

Farm Name Orrell No. 1

TOPS	DEPTH	LOG	DATUM
Anh. Stal		2265	
Tp.			
H.			
Tr.			
Dg.			
Bl.			
L.			
K.C.	2718	2718	
B.K.C.	2952		
Ce.			
C.			
M.	3300	3300	
M.	3363		
K.	3658	3658	
Mz.			
Mo.			
V.			
S. Stal	2365		
S.	3723	3723	
A	3772	3772	
R.			
P€.			
G.			
TD.	3824		

Loc. in Sec. NW NW NE

Geol.

Contr. White & Ellis Tools

Pool Wildcat

OCT 31 '56

ABANDONED

Date Comm. spd. 10-18-56 Shell (DHC)

8" @ 220 w/170, Stal 2365, Drlg. 3375

Arb. tst app. 3800' OCT 31 '55

DEA

Co. Lse. No. Sec. T. R.

WILDCAT

FORM 513 SUNRAY

Co.

County Sumner Elev.

Sec. 3 Twp. 30 Rge. 1E

Company White & Ellis & Pack Oil Co.

Farm Name Orrell No. 1

TOPS	DEPTH	LOG	DATUM
Anh.			
Tp.			
H.			
Tr.			
Dg.			
Bl.			
L.	2718		
K.C.	2952		
B.K.C.			
Ce.			
C.	3300		
M.	3323		
M.			
K.			
Mz.			
Mc.			
V.			
S. Stal	2365		
S.			
A			
R.			
P€.			
G.			
T.D.			

Loc. in Sec. NW NW NE

Geol.

Contr. White & Ellis

Lse.

Pool Tools

Wildcat

OCT 24 56

FIRST REPORT

No.

Date Comm. spd. 10-18-56 Shell (DHM)

Sec.

8" @ 220 w/170, Stal 2365, Drlg. 3375

Arb. tst app. 3800'

T.

NOV 2 7 1956

R.

O. C.