

Cowley

KANSAS  
3E

11

33

SECTION \_\_\_\_\_ TOWNSHIP \_\_\_\_\_ RANGE \_\_\_\_\_


#2 Boyles

WELL NO. \_\_\_\_\_

Wakefield

COMPANY \_\_\_\_\_

NORTH SE NW SW

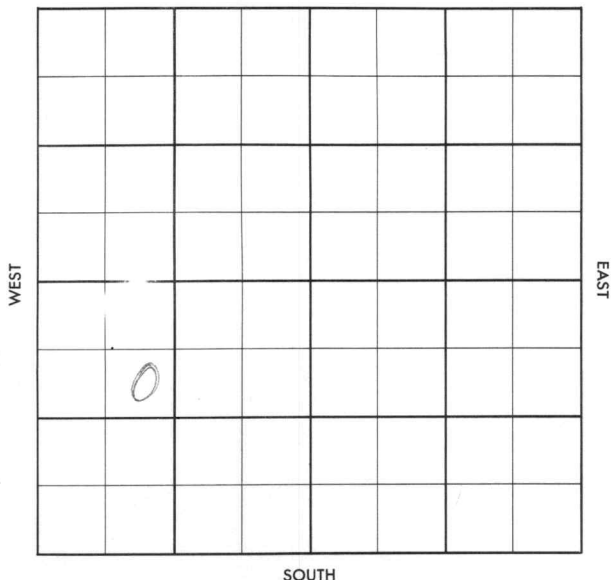

County Cowley Elev. \_\_\_\_\_  
 Sec. 11 Twp. 33 Rge. 3E  
 Company Wakefield  
 Farm Name Boyles No. 2

TOPS	DEPTH	LOG	DATUM	Loc. in Sec. _____																
Anh.				SE NW SW																
Tp.																				
H.																				
Tr.																				
Dg.																				
Bl.																				
L.				Geol. _____																
K.C.				Contr. _____																
B.K.C.				Co. Tools _____																
Ce.				Pool _____																
C.				Graham																
M.				<table border="1"> <tr> <td></td> <td></td> <td></td> <td></td> </tr> <tr> <td></td> <td></td> <td></td> <td></td> </tr> <tr> <td></td> <td></td> <td></td> <td></td> </tr> <tr> <td></td> <td></td> <td></td> <td></td> </tr> </table>																
M.																				
K.																				
Mz.																				
Mq.																				
V.																				
S.																				
S.																				
A.																				
R.																				
Pe.																				
G.																				
T.D.																				

Date Comm. 3-19-57  
Spudding

*29*

Co.  
Lse.  
No.  
Sec.  
T.  
R.

FIRST REPORT

MAR 20 1957

County Cowley Elev. 1158  
 Sec. 11 Twp. 33 Rge. 3E  
 Company Wakefield  
 Farm Name Boyles No. 2

TOPS	DEPTH	LOG	DATUM
Anh.			
Tr.			
H. <u>Lay</u>	<u>2627</u>		
Tr.			
Dg. <u>Bartl</u>	<u>3292</u>		
BL.			
L.			
K.C.			
B.K.C.			
Ce.			
C.			
M.			
M.			
K.			
Mz.			
Mo.			
V.			
S.			
S.			
A.			
R.			
PE.			
G.			
TD.	<u>3300</u>		

Loc. in Sec. SE NW SW  
 Geol. \_\_\_\_\_  
 Contr. \_\_\_\_\_  
 Co. Tools \_\_\_\_\_  
 Pool \_\_\_\_\_  
Graham  
**COMPLETE**  
 JUN 12 '57

Date Comm. 3-19-57  
 Spudding WOC 8 5/8 80  
5 1/2 3293 APR 3 '57 ✓ APR 10 '57 ✓  
 APR 17 '57 WOC APR 24 '57 MAY 1 '57 ✓ MAY 8 '57 ✓  
 MAY 15 '57 MICT CO MAY 22 '57 CO. MAY 29 '57  
X MICT CO 3300 (stuck)  
1st q. JUN 5 '57 JUN 12 '57 Frac FU  
100' BO + 75 BW 8 hrs Pot  
P. 25 Bopd 75% w to.